



- SHEET NOTES: (#)
1. REFER TO AV DRAWINGS FOR ADDITIONAL INFORMATION
 2. REFER TO SECURITY DRAWINGS FOR ADDITIONAL INFORMATION.

1 TELECOM LOWER CONCOURSE - AREA NW
3/32" = 1'-0"

KEYPLAN

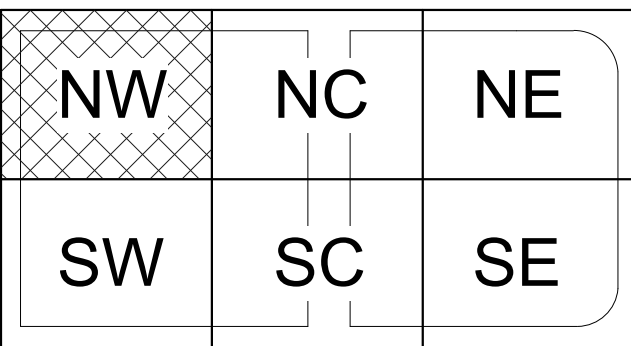


DRAWING INFORMATION		KENTUCKY INTERNATIONAL CONVENTION CENTER RENOVATION AND EXPANSION	
A&E FILE NO.	14.03019.00	TELECOM LOWER CONCOURSE - AREA NW	
DRAWING DATE	09/19/16	DRAWING NO.	
DRAWN BY	RZ	T100A	
CHECKED BY	JF	AS BUILT DATE	
PHASE	D	DECA LOG #	
RTA DATE			
		COMMONWEALTH OF KENTUCKY FINANCE AND ADMINISTRATION CABINET DEPARTMENT FOR FACILITIES & SUPPORT SERVICES DIVISION OF ENGINEERING AND CONTRACT ADMINISTRATION FRANKFORT, KENTUCKY	
		REVISION HISTORY OF THIS DRAWING	
		DESCRIPTION OF REVISIONS	DATE
		100 CONSOLIDATED CONSTRUCTION SET	05/22/17
		101 PR#	9/20/2017

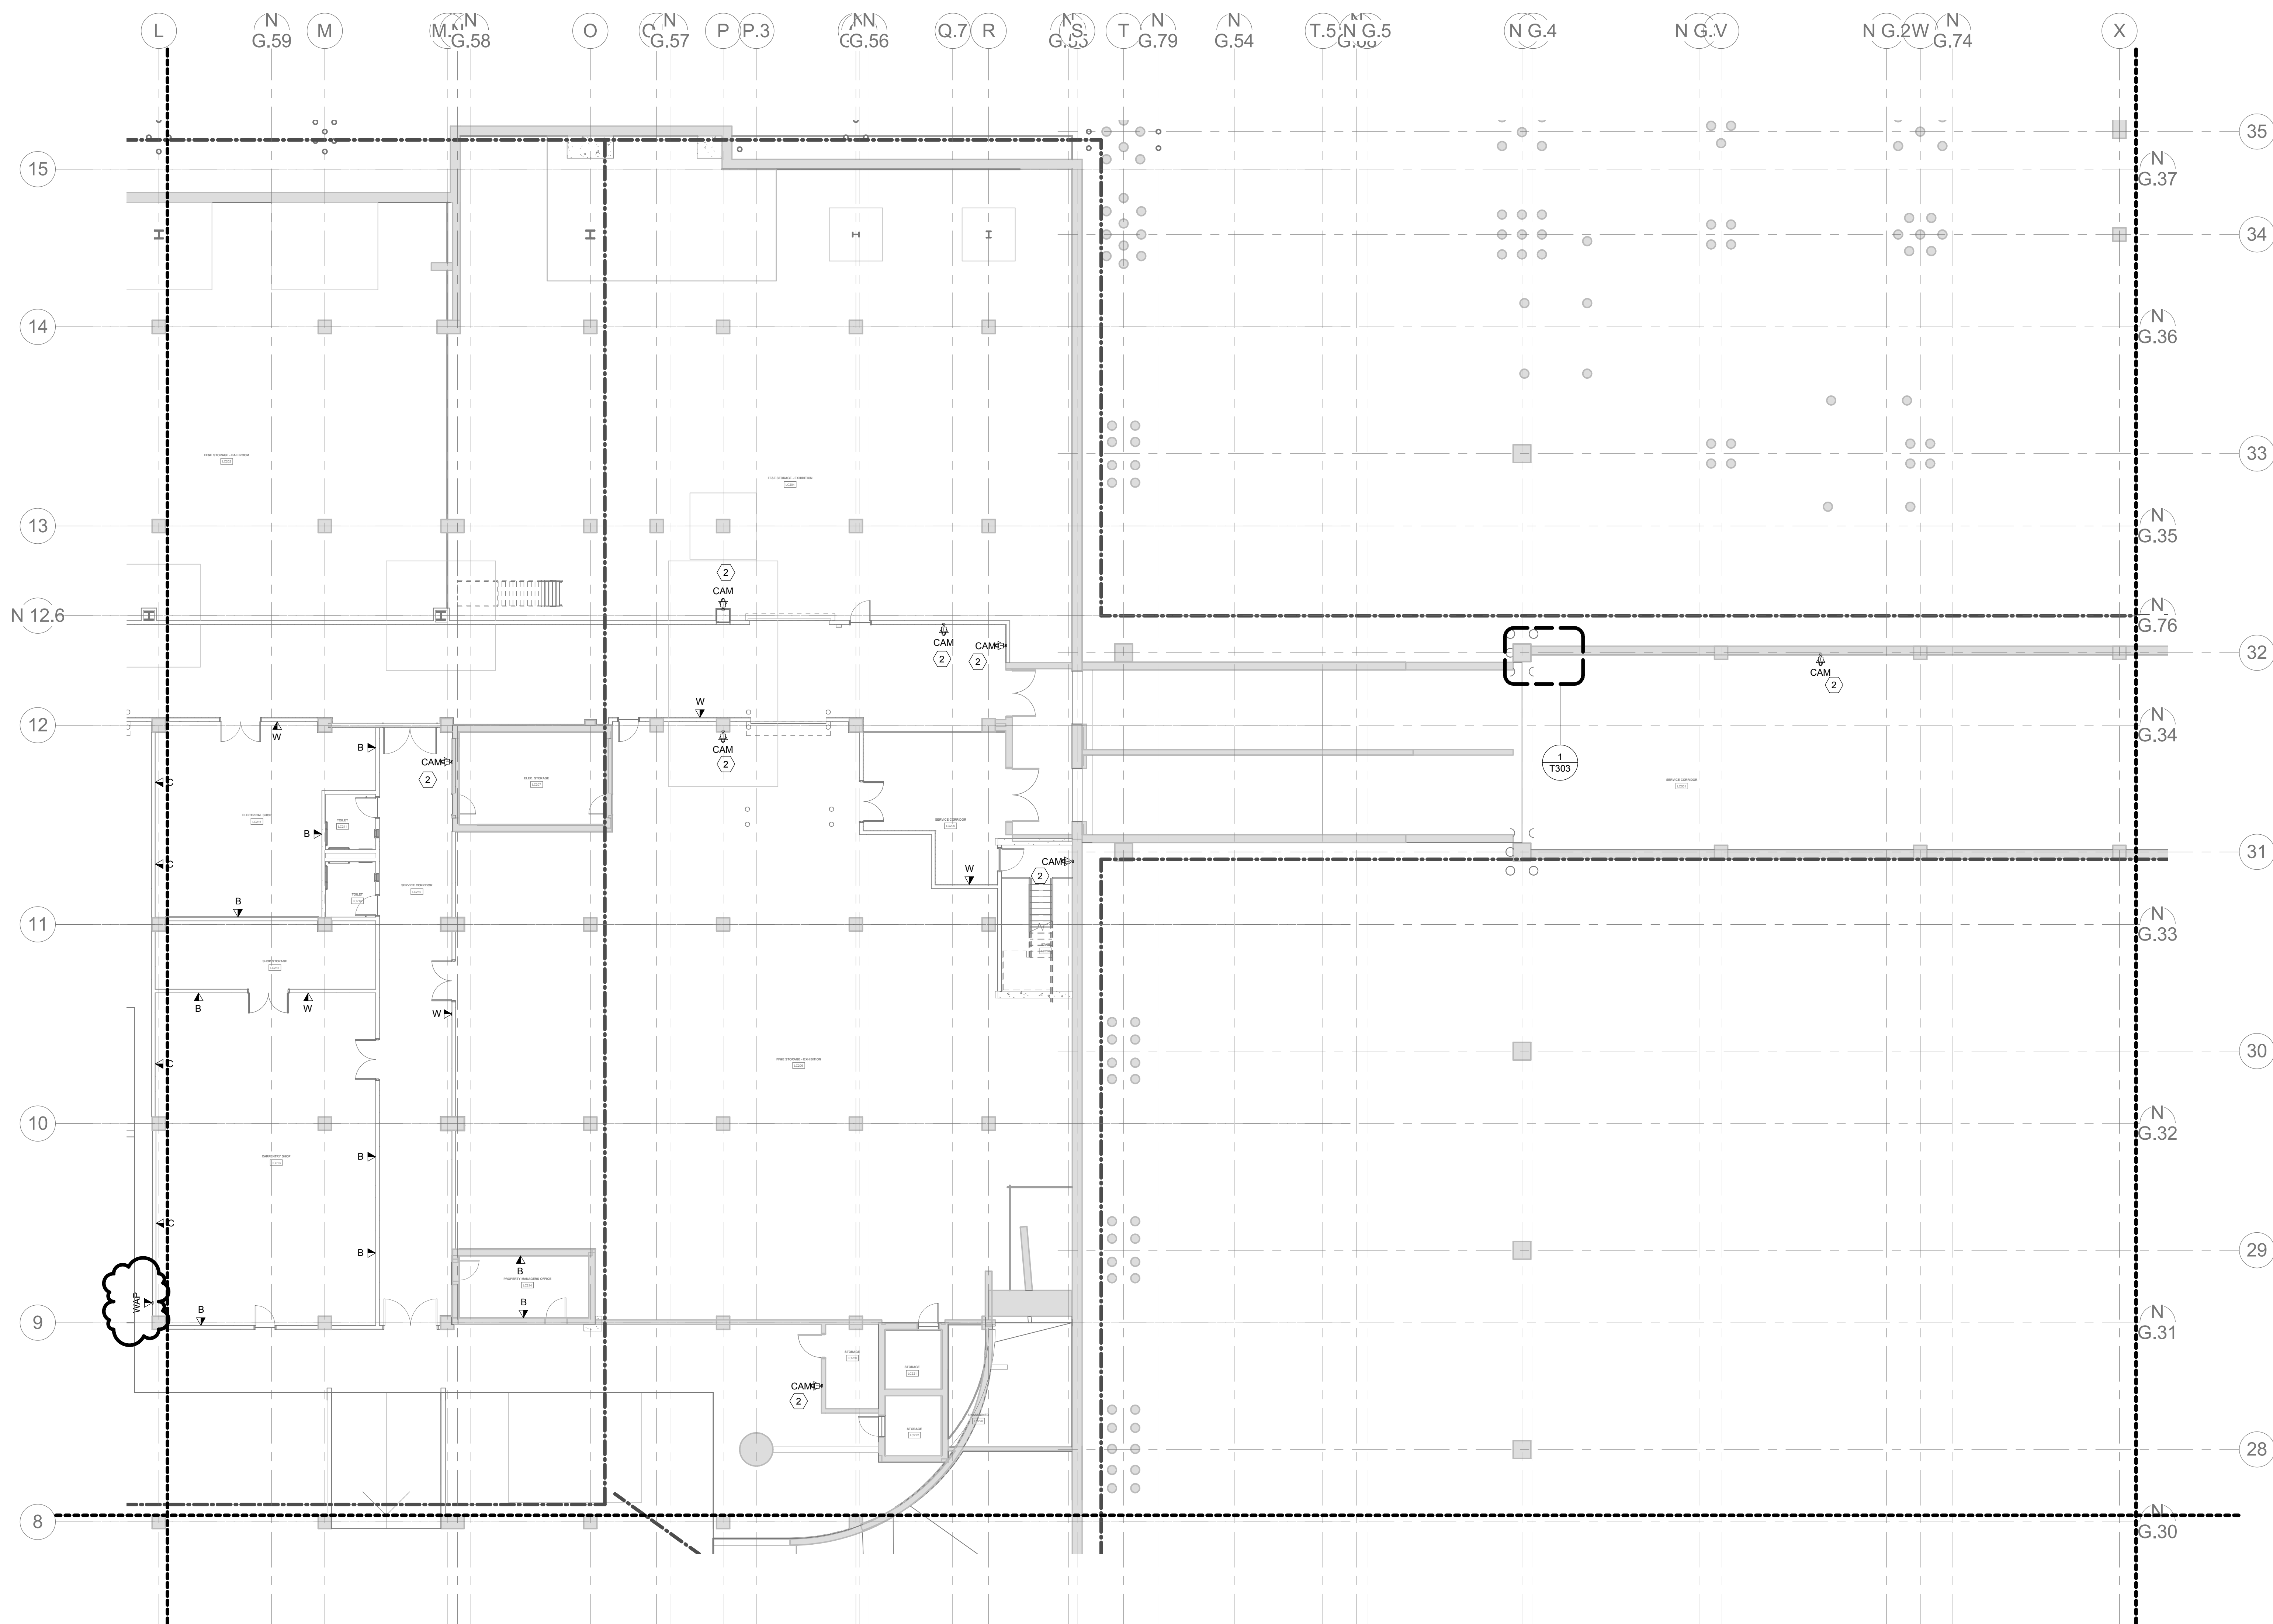

- SHEET NOTES:**
1. REFER TO AV DRAWINGS FOR ADDITIONAL INFORMATION.
 2. REFER TO SECURITY DRAWINGS FOR ADDITIONAL INFORMATION.

1 TELECOM LOWER CONCOURSE - AREA NC
3/32" = 1'-0"

KEYPLAN

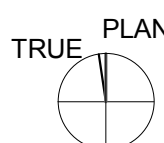

NW	NC	NE
SW	SC	SE

DRAWING INFORMATION	
A&E FILE NO.	14.03019.00
DRAWING DATE	09/19/16
DRAWN BY	RZ
CHECKED BY	JF
RTA DATE	D

KENTUCKY INTERNATIONAL CONVENTION CENTER
RENOVATION AND EXPANSION

TELECOM LOWER CONCOURSE - AREA NC

ACCOUNT NO. 235 C77K
COMMONWEALTH OF KENTUCKY
FINANCE AND ADMINISTRATION CABINET
DEPARTMENT FOR FACILITIES & SUPPORT SERVICES
DIVISION OF ENGINEERING AND CONTRACT ADMINISTRATION
FRANKFORT, KENTUCKY



DESCRIPTION OF REVISIONS	DATE	DESCRIPTION OF REVISIONS	DATE
100 CONSOLIDATED CONSTRUCTION SET	05/22/17		
101 PR#	9/20/2017		


DRAWING NO.

T100C

AS BUILT DATE

DECA LOG #



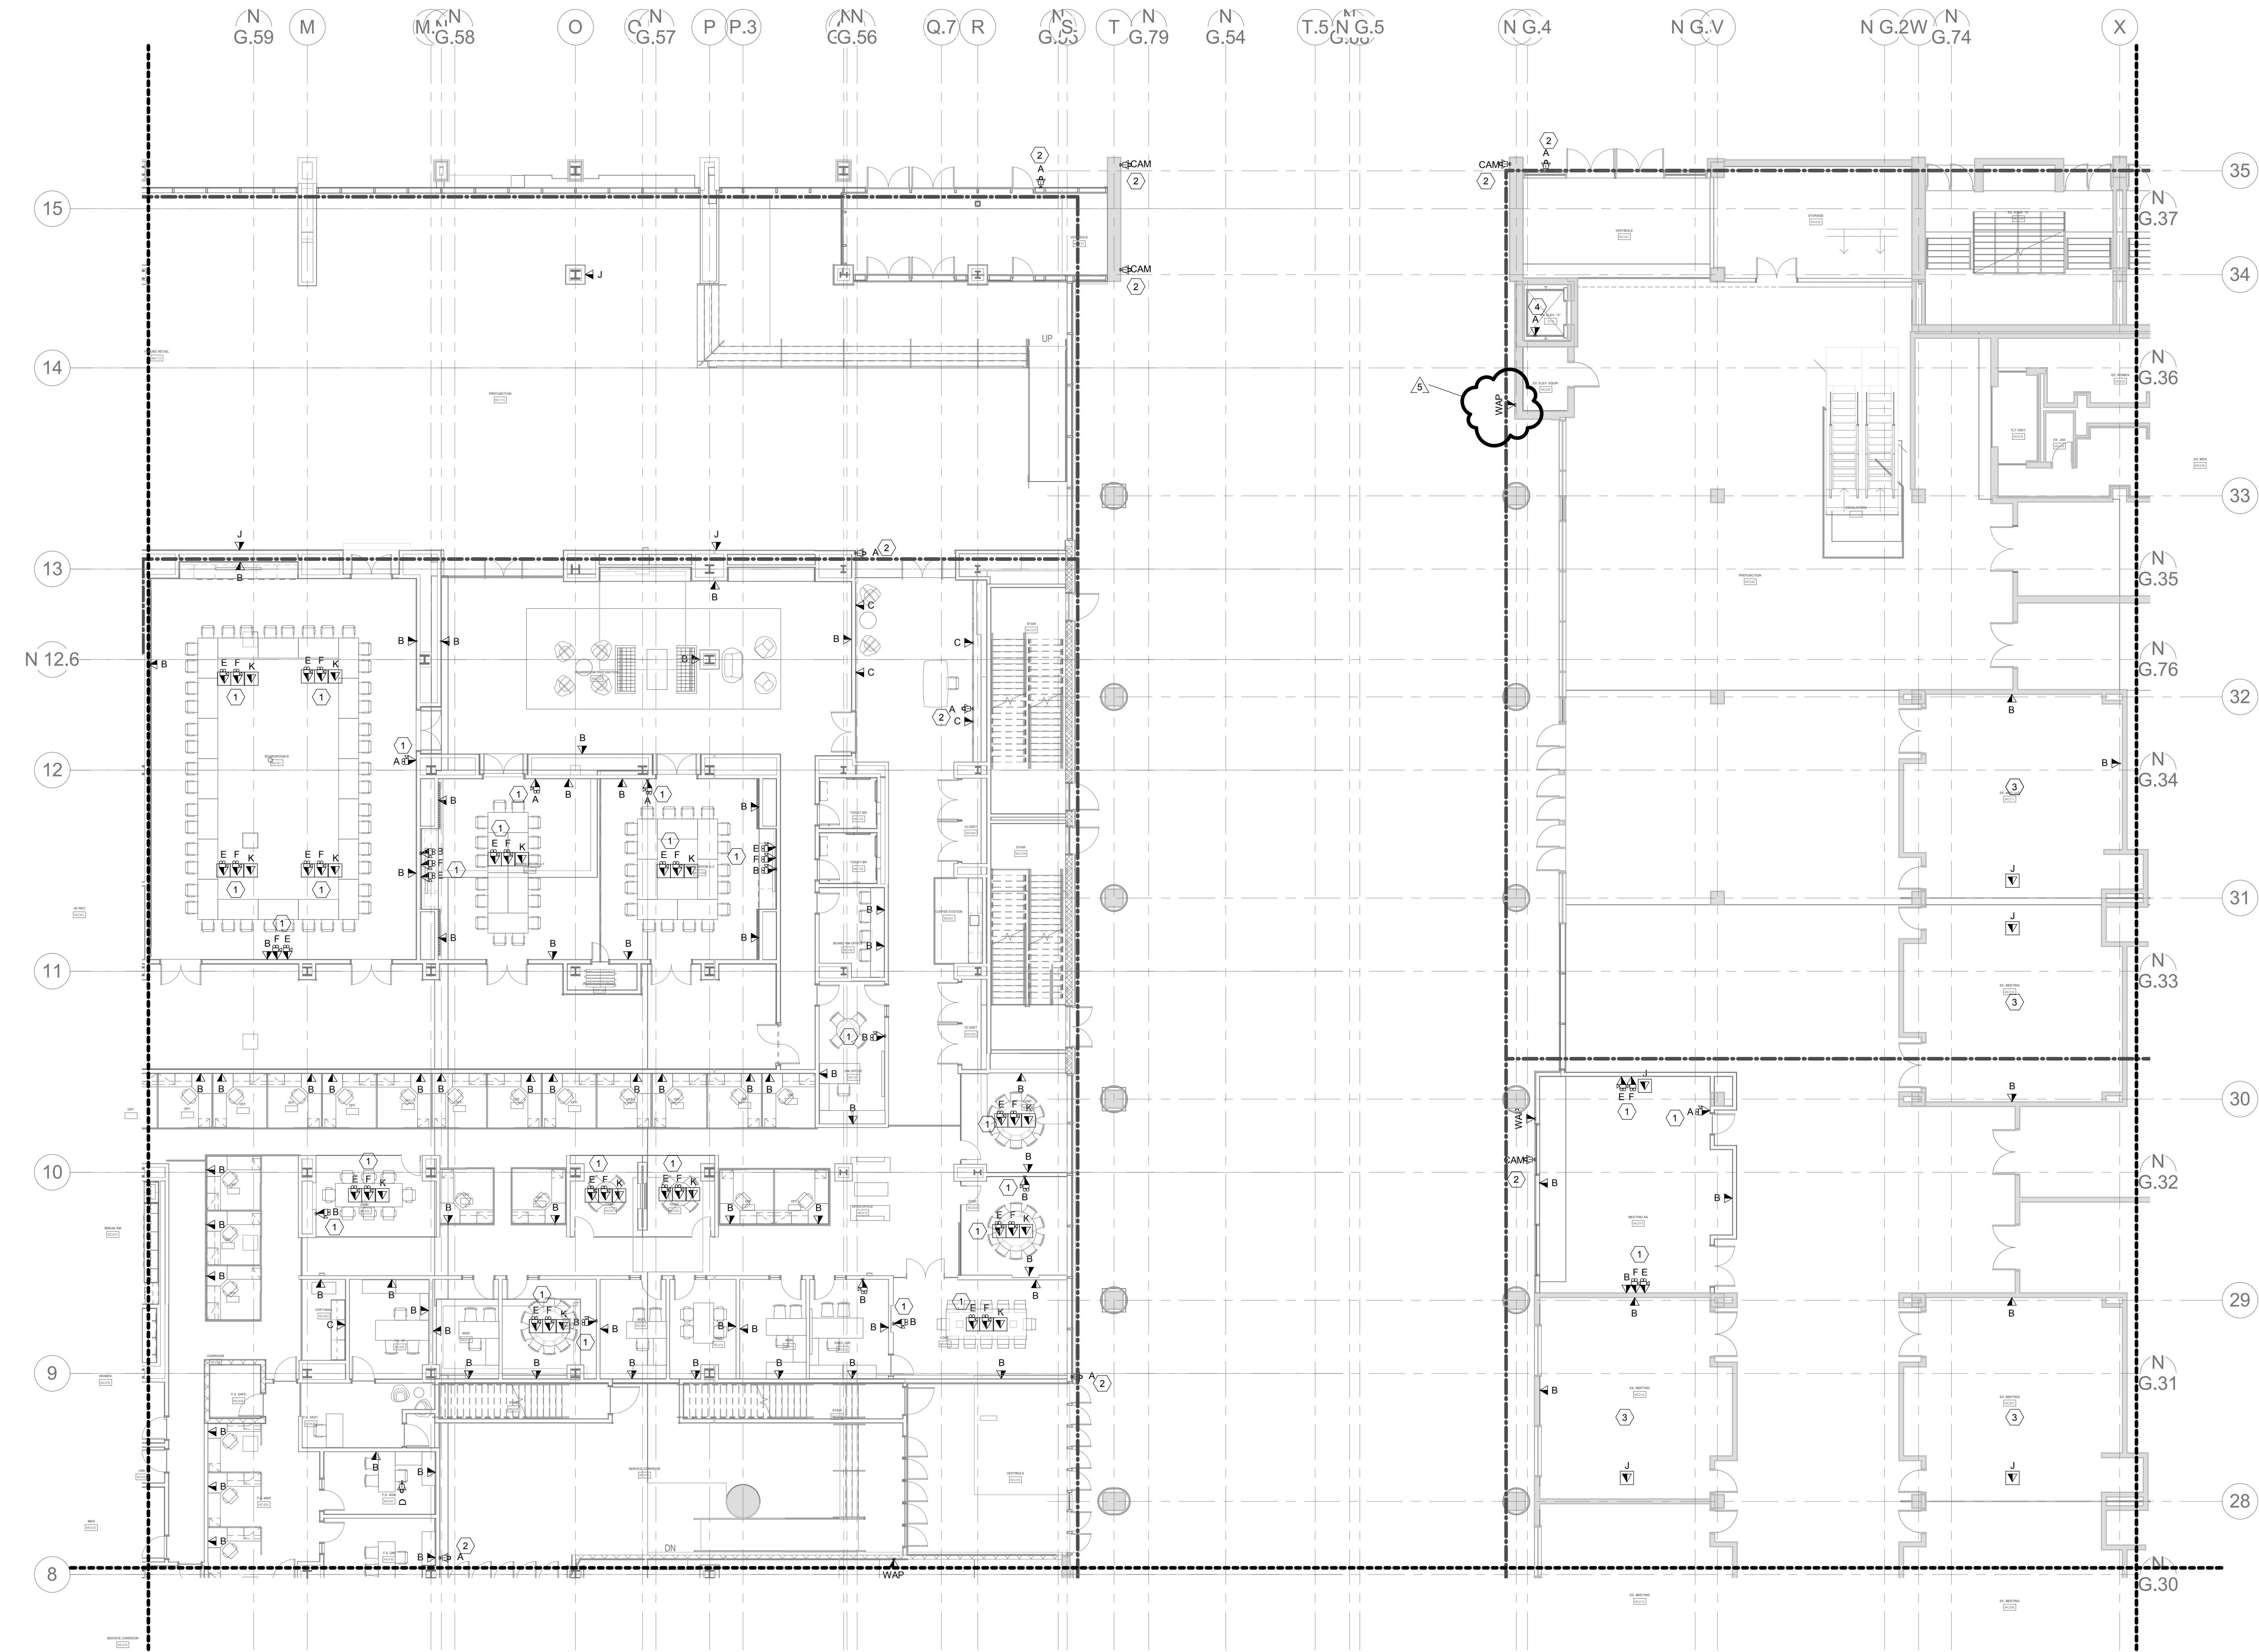


1 TELECOM MAIN CONCOURSE - AREA NC
3/32" = 1'-0"

GENERAL NOTES:

1. IT SCOPE FOR EXISTING AV ROOMS IS AS FOLLOWS: RETAIN EXISTING BACKBOXES, FLOORBOXES AND CONDUIT PATHWAYS TO EXISTING TELECOM ROOMS. EXISTING CABLING TO BE REMOVED AND REPLACED WITH NEW CABLE.
 2. DURING REMOVAL AND PRIOR TO INSTALLING NEW CABLE, NOTIFY GENERAL CONTRACTOR IF EXISTING PATHWAYS WILL NOT SUPPORT NEW CONFIGURATION.
- SHEET NOTES: (#)
1. REFER TO AV DRAWINGS FOR ADDITIONAL INFORMATION
 2. REFER TO SECURITY DRAWINGS FOR ADDITIONAL INFORMATION.
 3. EXISTING LIGHTING CONTROL PANELS AND CABLING TO REMAIN; LIGHTING SYSTEM UPGRADE LISTED SEPARATELY AS AN ADD ALTERNATE. ADD ALTERNATE TO INCLUDE (1) CAT6A CABLE TO NEW AV CONTROL PANEL AND (1) CAT6A CABLE TO IN CEILING LIGHTING CONTROL DEVICE.
 4. INSTALL ELEVATOR CABLING TO THE CORRESPONDING ELEVATOR MACHINE ROOM

KEYPLAN

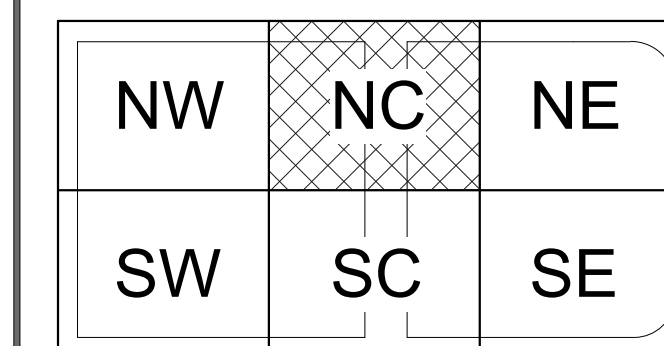


DRAWING INFORMATION	
A&E FILE NO.	14.03019.00
DRAWING DATE	09/19/16
DRAWN BY	RZ
CHECKED BY	JF
PHASE	D
RTA DATE	



KENTUCKY INTERNATIONAL CONVENTION CENTER
RENOVATION AND EXPANSION

TELECOM MAIN CONCOURSE - AREA NC		DRAWING NO.
ACCOUNT NO.	COMMONWEALTH OF KENTUCKY FINANCE AND ADMINISTRATION CABINET DEPARTMENT FOR FACILITIES & SUPPORT SERVICES DIVISION OF ENGINEERING AND CONTRACT ADMINISTRATION FRANKFORT, KENTUCKY	T110C
		AS BUILT DATE
		DECA LOG #
REVISION HISTORY OF THIS DRAWING		
DESCRIPTION OF REVISIONS	DATE	DESCRIPTION OF REVISIONS
100 CONSOLIDATED CONSTRUCTION SET	05/22/17	
101 PR#	9/20/2017	

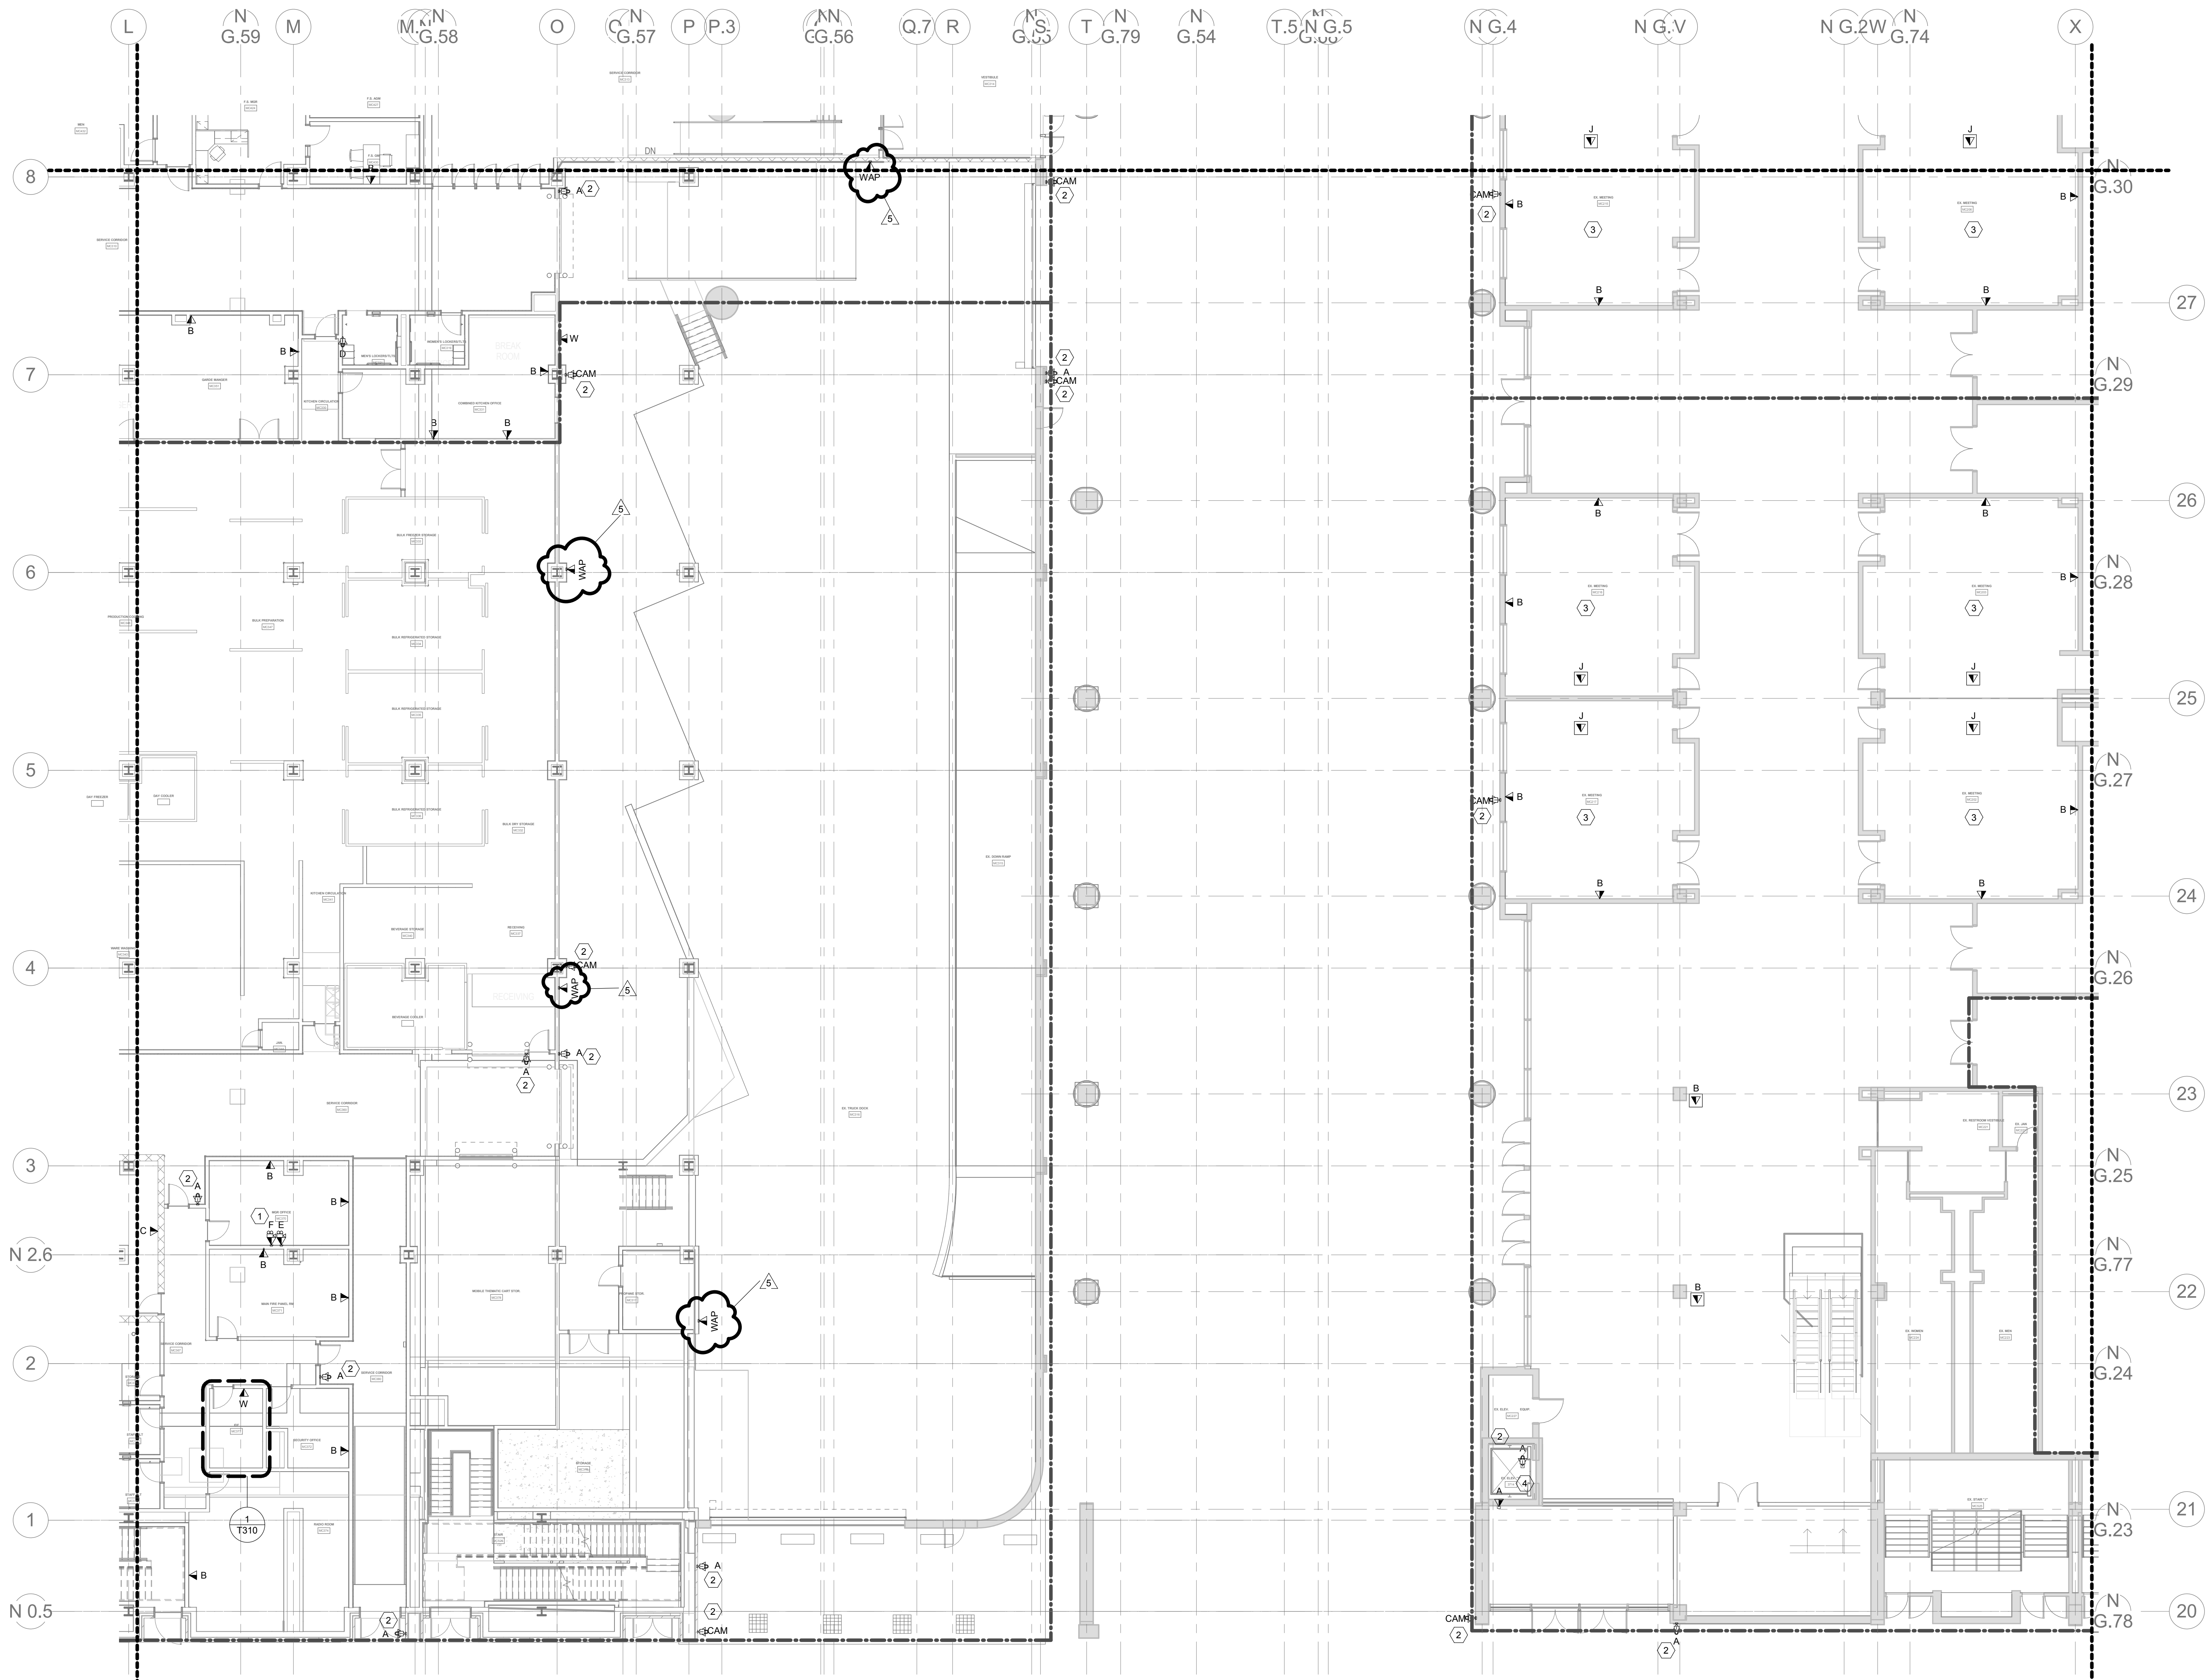

1 TELECOM MAIN CONCOURSE - AREA SC
3/32" = 1'-0"


GENERAL NOTES:

1. IT SCOPE FOR EXISTING AV ROOMS IS AS FOLLOWS: RETAIN EXISTING BACKBOXES, FLOORBOXES AND CONDUIT PATHWAYS TO EXISTING TELECOM ROOMS. EXISTING CABLING TO BE REMOVED AND REPLACED WITH NEW CABLE.
2. DURING REMOVAL AND PRIOR TO INSTALLING NEW CABLE, NOTIFY GENERAL CONTRACTOR IF EXISTING PATHWAYS WILL NOT SUPPORT NEW CONFIGURATION.


SHEET NOTES: (#)

1. REFER TO AV DRAWINGS FOR ADDITIONAL INFORMATION.
2. REFER TO SECURITY DRAWINGS FOR ADDITIONAL INFORMATION.
3. EXISTING LIGHTING CONTROL PANELS AND CABLING TO REMAIN; LIGHTING SYSTEM UPGRADE LISTED SEPARATELY AS AN ADD ALTERNATE. ADD ALTERNATE TO INCLUDE: (1) CAT6A CABLE TO NEW AV CONTROL PANEL AND (1) CAT6A CABLE TO IN CEILING LIGHTING CONTROL DEVICE.
4. INSTALL ELEVATOR CABLING TO THE CORRESPONDING ELEVATOR MACHINE ROOM.

KEYPLAN

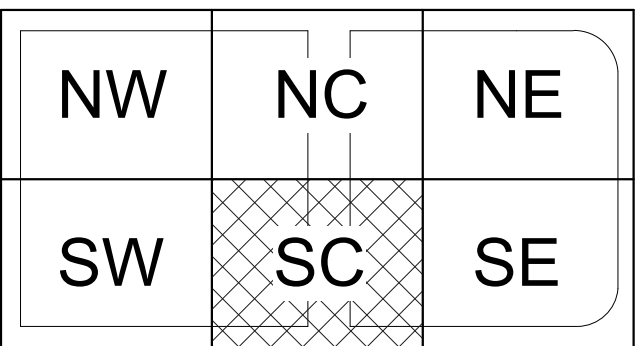


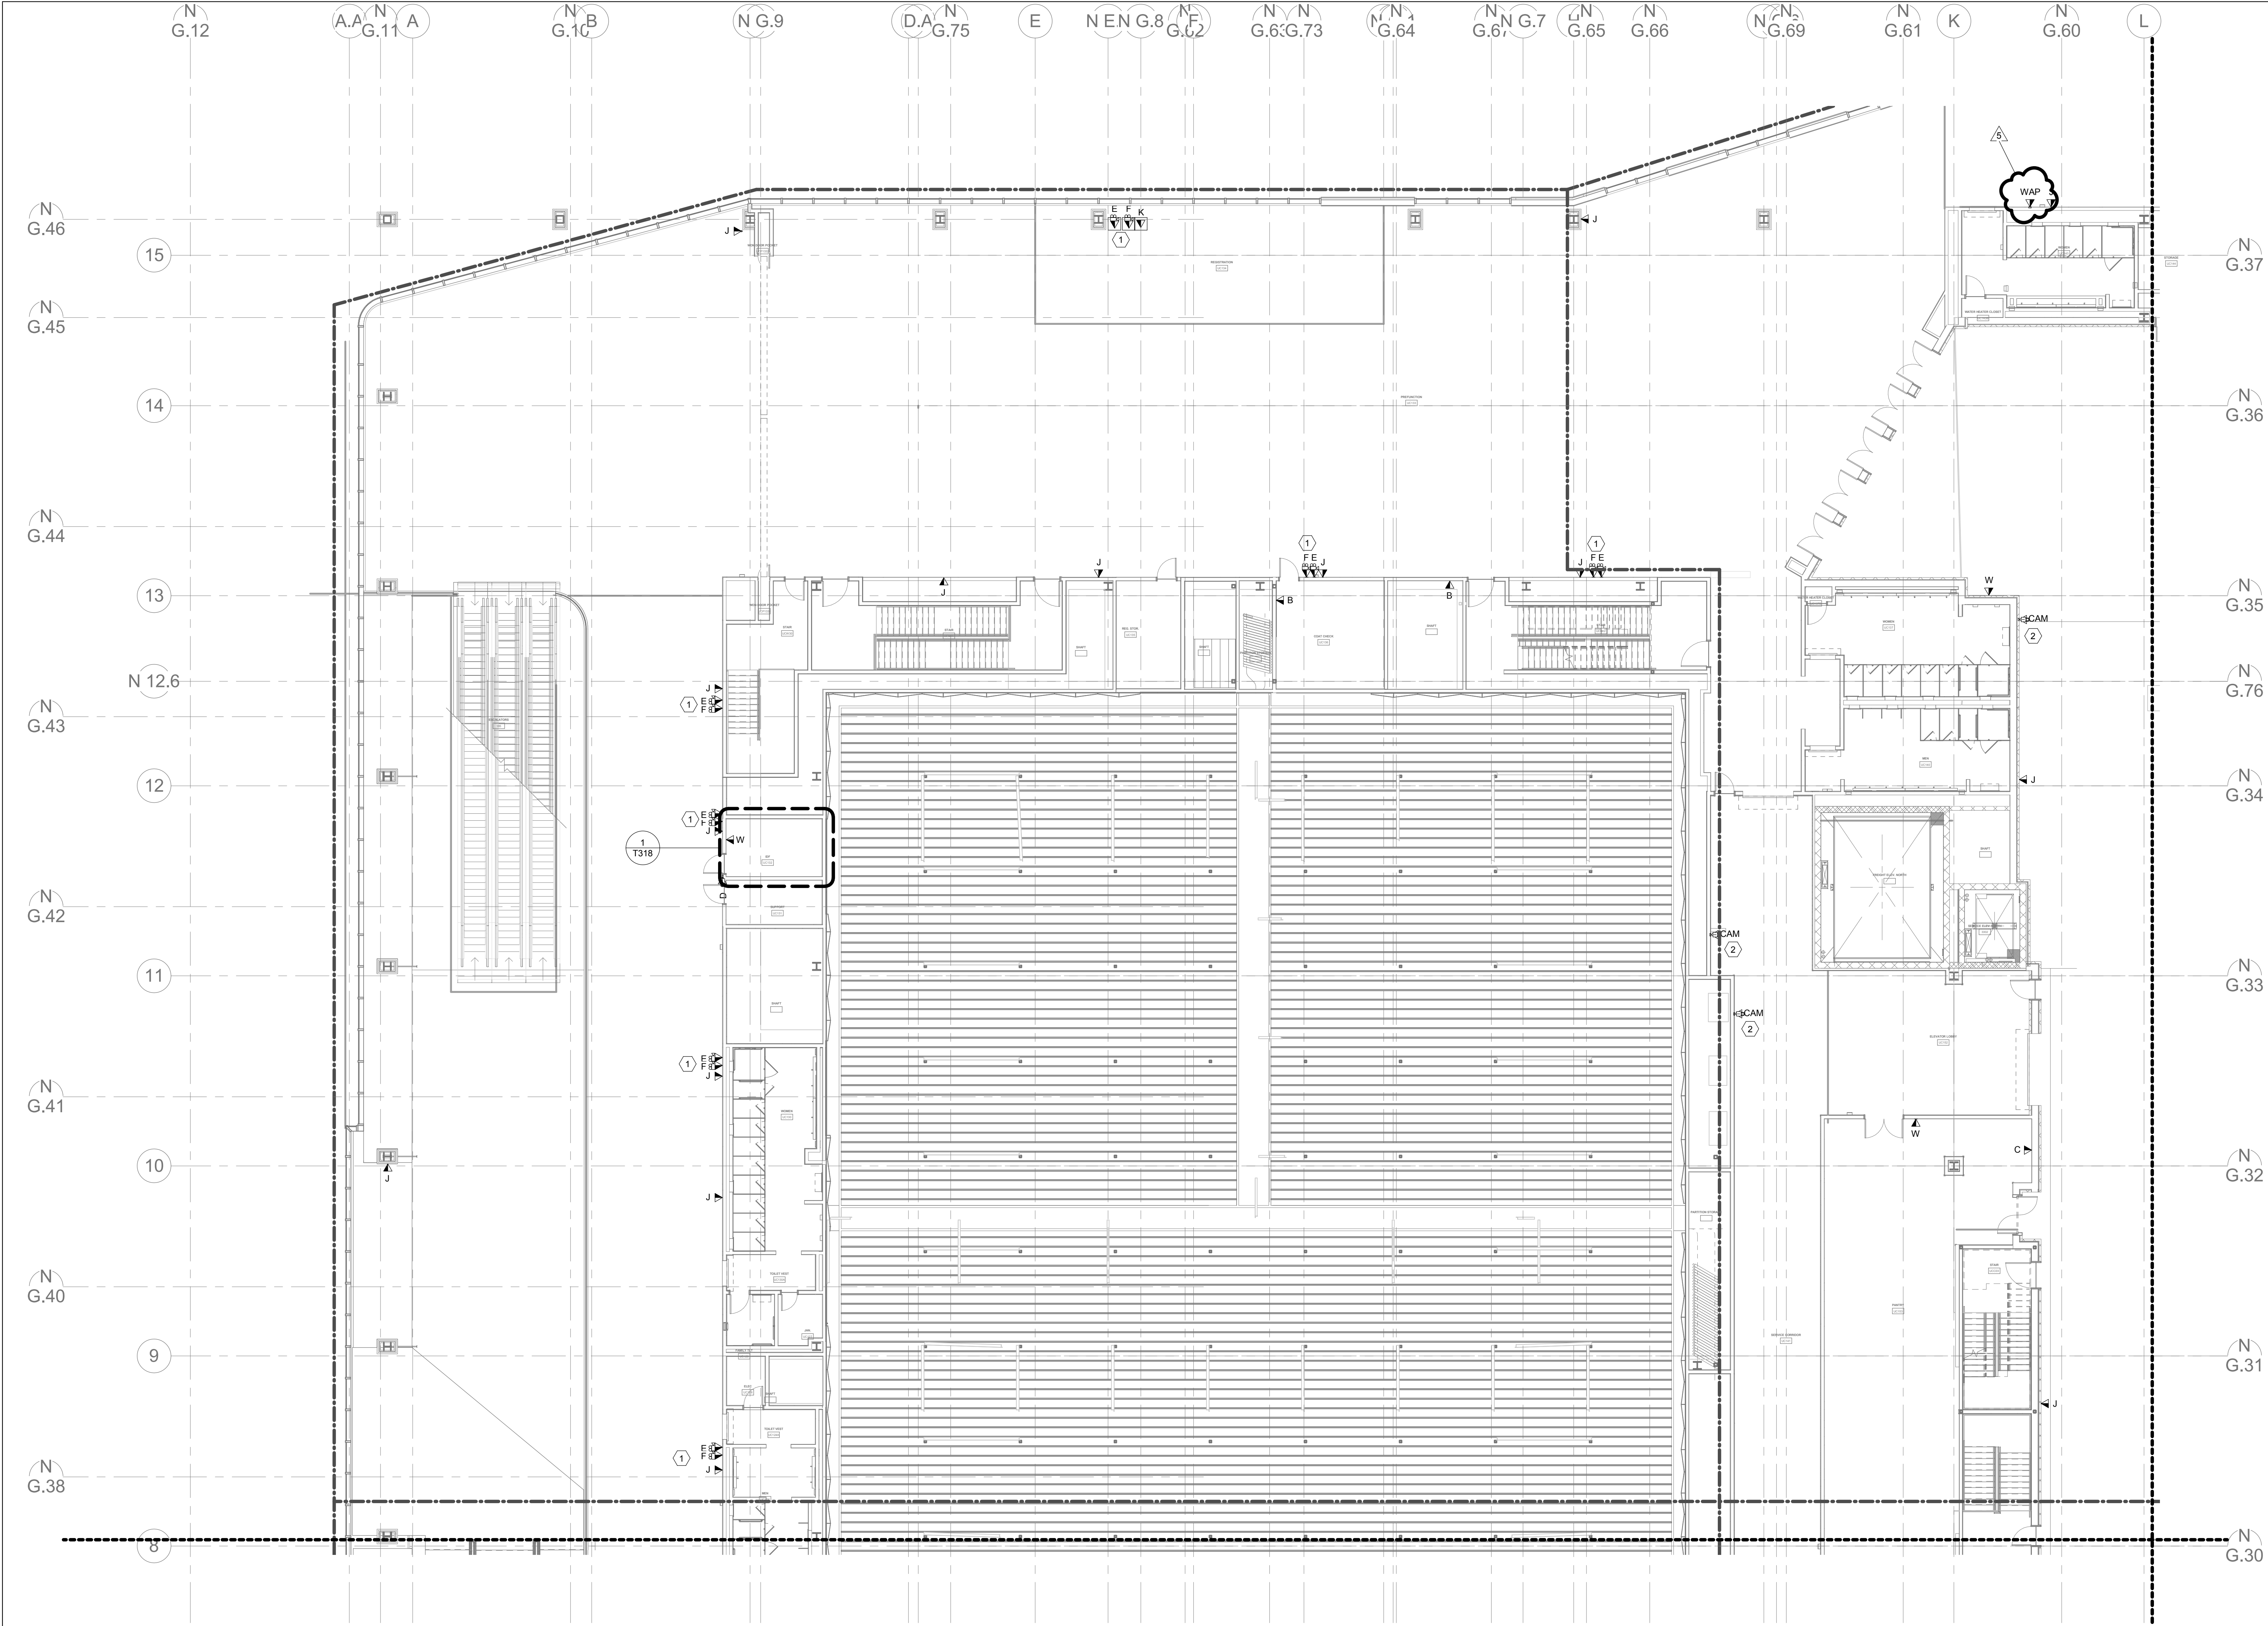

DRAWING INFORMATION		KENTUCKY INTERNATIONAL CONVENTION CENTER RENOVATION AND EXPANSION		DRAWING NO.	
A&E FILE NO.	14.03019.00	TELECOM MAIN CONCOURSE - AREA SC		T110D	
DRAWING DATE	09/19/16	ACCOUNT NO. 235 C77K		COMMONWEALTH OF KENTUCKY FINANCE AND ADMINISTRATION CABINET DEPARTMENT FOR FACILITIES & SUPPORT SERVICES DIVISION OF ENGINEERING AND CONTRACT ADMINISTRATION FRANKFORT, KENTUCKY	
DRAWN BY	RZ	COMMONWEALTH OF KENTUCKY FINANCE AND ADMINISTRATION CABINET DEPARTMENT FOR FACILITIES & SUPPORT SERVICES DIVISION OF ENGINEERING AND CONTRACT ADMINISTRATION FRANKFORT, KENTUCKY		AS BUILT DATE	
CHECKED BY	JF	COMMONWEALTH OF KENTUCKY FINANCE AND ADMINISTRATION CABINET DEPARTMENT FOR FACILITIES & SUPPORT SERVICES DIVISION OF ENGINEERING AND CONTRACT ADMINISTRATION FRANKFORT, KENTUCKY		DECA LOG #	
PHASE	D	COMMONWEALTH OF KENTUCKY FINANCE AND ADMINISTRATION CABINET DEPARTMENT FOR FACILITIES & SUPPORT SERVICES DIVISION OF ENGINEERING AND CONTRACT ADMINISTRATION FRANKFORT, KENTUCKY		DECA LOG #	
RTA DATE		COMMONWEALTH OF KENTUCKY FINANCE AND ADMINISTRATION CABINET DEPARTMENT FOR FACILITIES & SUPPORT SERVICES DIVISION OF ENGINEERING AND CONTRACT ADMINISTRATION FRANKFORT, KENTUCKY		DECA LOG #	
DRAWING		REVISION HISTORY OF THIS DRAWING		DATE	
DESCRIPTION OF REVISIONS		DATE		DESCRIPTION OF REVISIONS	
100 CONSOLIDATED CONSTRUCTION SET		05/22/17			
101 PR#		9/20/2017			




- SHEET NOTES:** (#)
1. REFER TO AV DRAWINGS FOR ADDITIONAL INFORMATION
 2. REFER TO SECURITY DRAWINGS FOR ADDITIONAL INFORMATION.

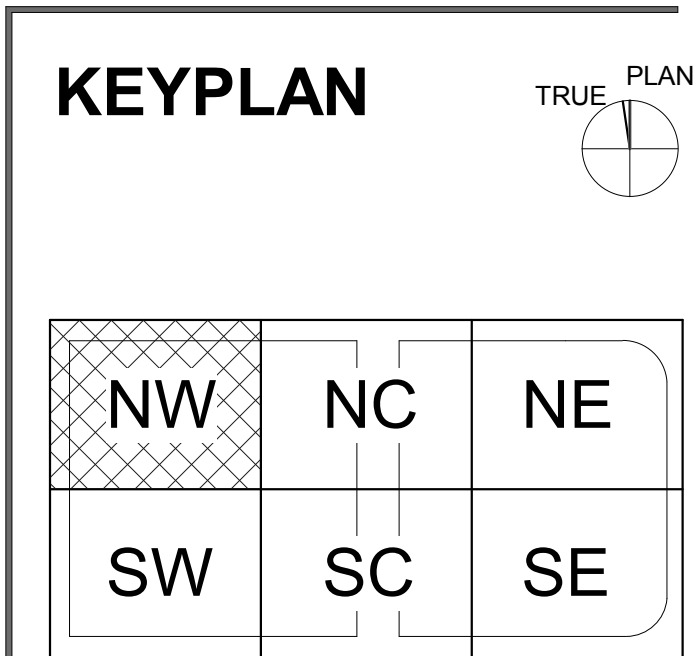① TELECOM UPPER CONCOURSE - AREA NW
3/32" = 1'-0"




DRAWING INFORMATION		KENTUCKY INTERNATIONAL CONVENTION CENTER RENOVATION AND EXPANSION				
A&E FILE NO.	14.03019.00	TELECOM UPPER CONCOURSE - AREA NW		DRAWING NO.		
DRAWING DATE	09/19/16			T120A		
DRAWN BY	RZ	ACCOUNT NO.	COMMONWEALTH OF KENTUCKY FINANCE AND ADMINISTRATION CABINET DEPARTMENT FOR FACILITIES & SUPPORT SERVICES DIVISION OF ENGINEERING AND CONTRACT ADMINISTRATION FRANKFORT, KENTUCKY			
CHECKED BY	JF	235 C77K				
PHASE	D				AS BUILT DATE	
RTA DATE					DECA LOG #	
		REVISION HISTORY OF THIS DRAWING				
		DESCRIPTION OF REVISIONS		DATE	DESCRIPTION OF REVISIONS	DATE
		100 CONSOLIDATED CONSTRUCTION SET		05/22/17		
		101 PR#		9/20/2017		

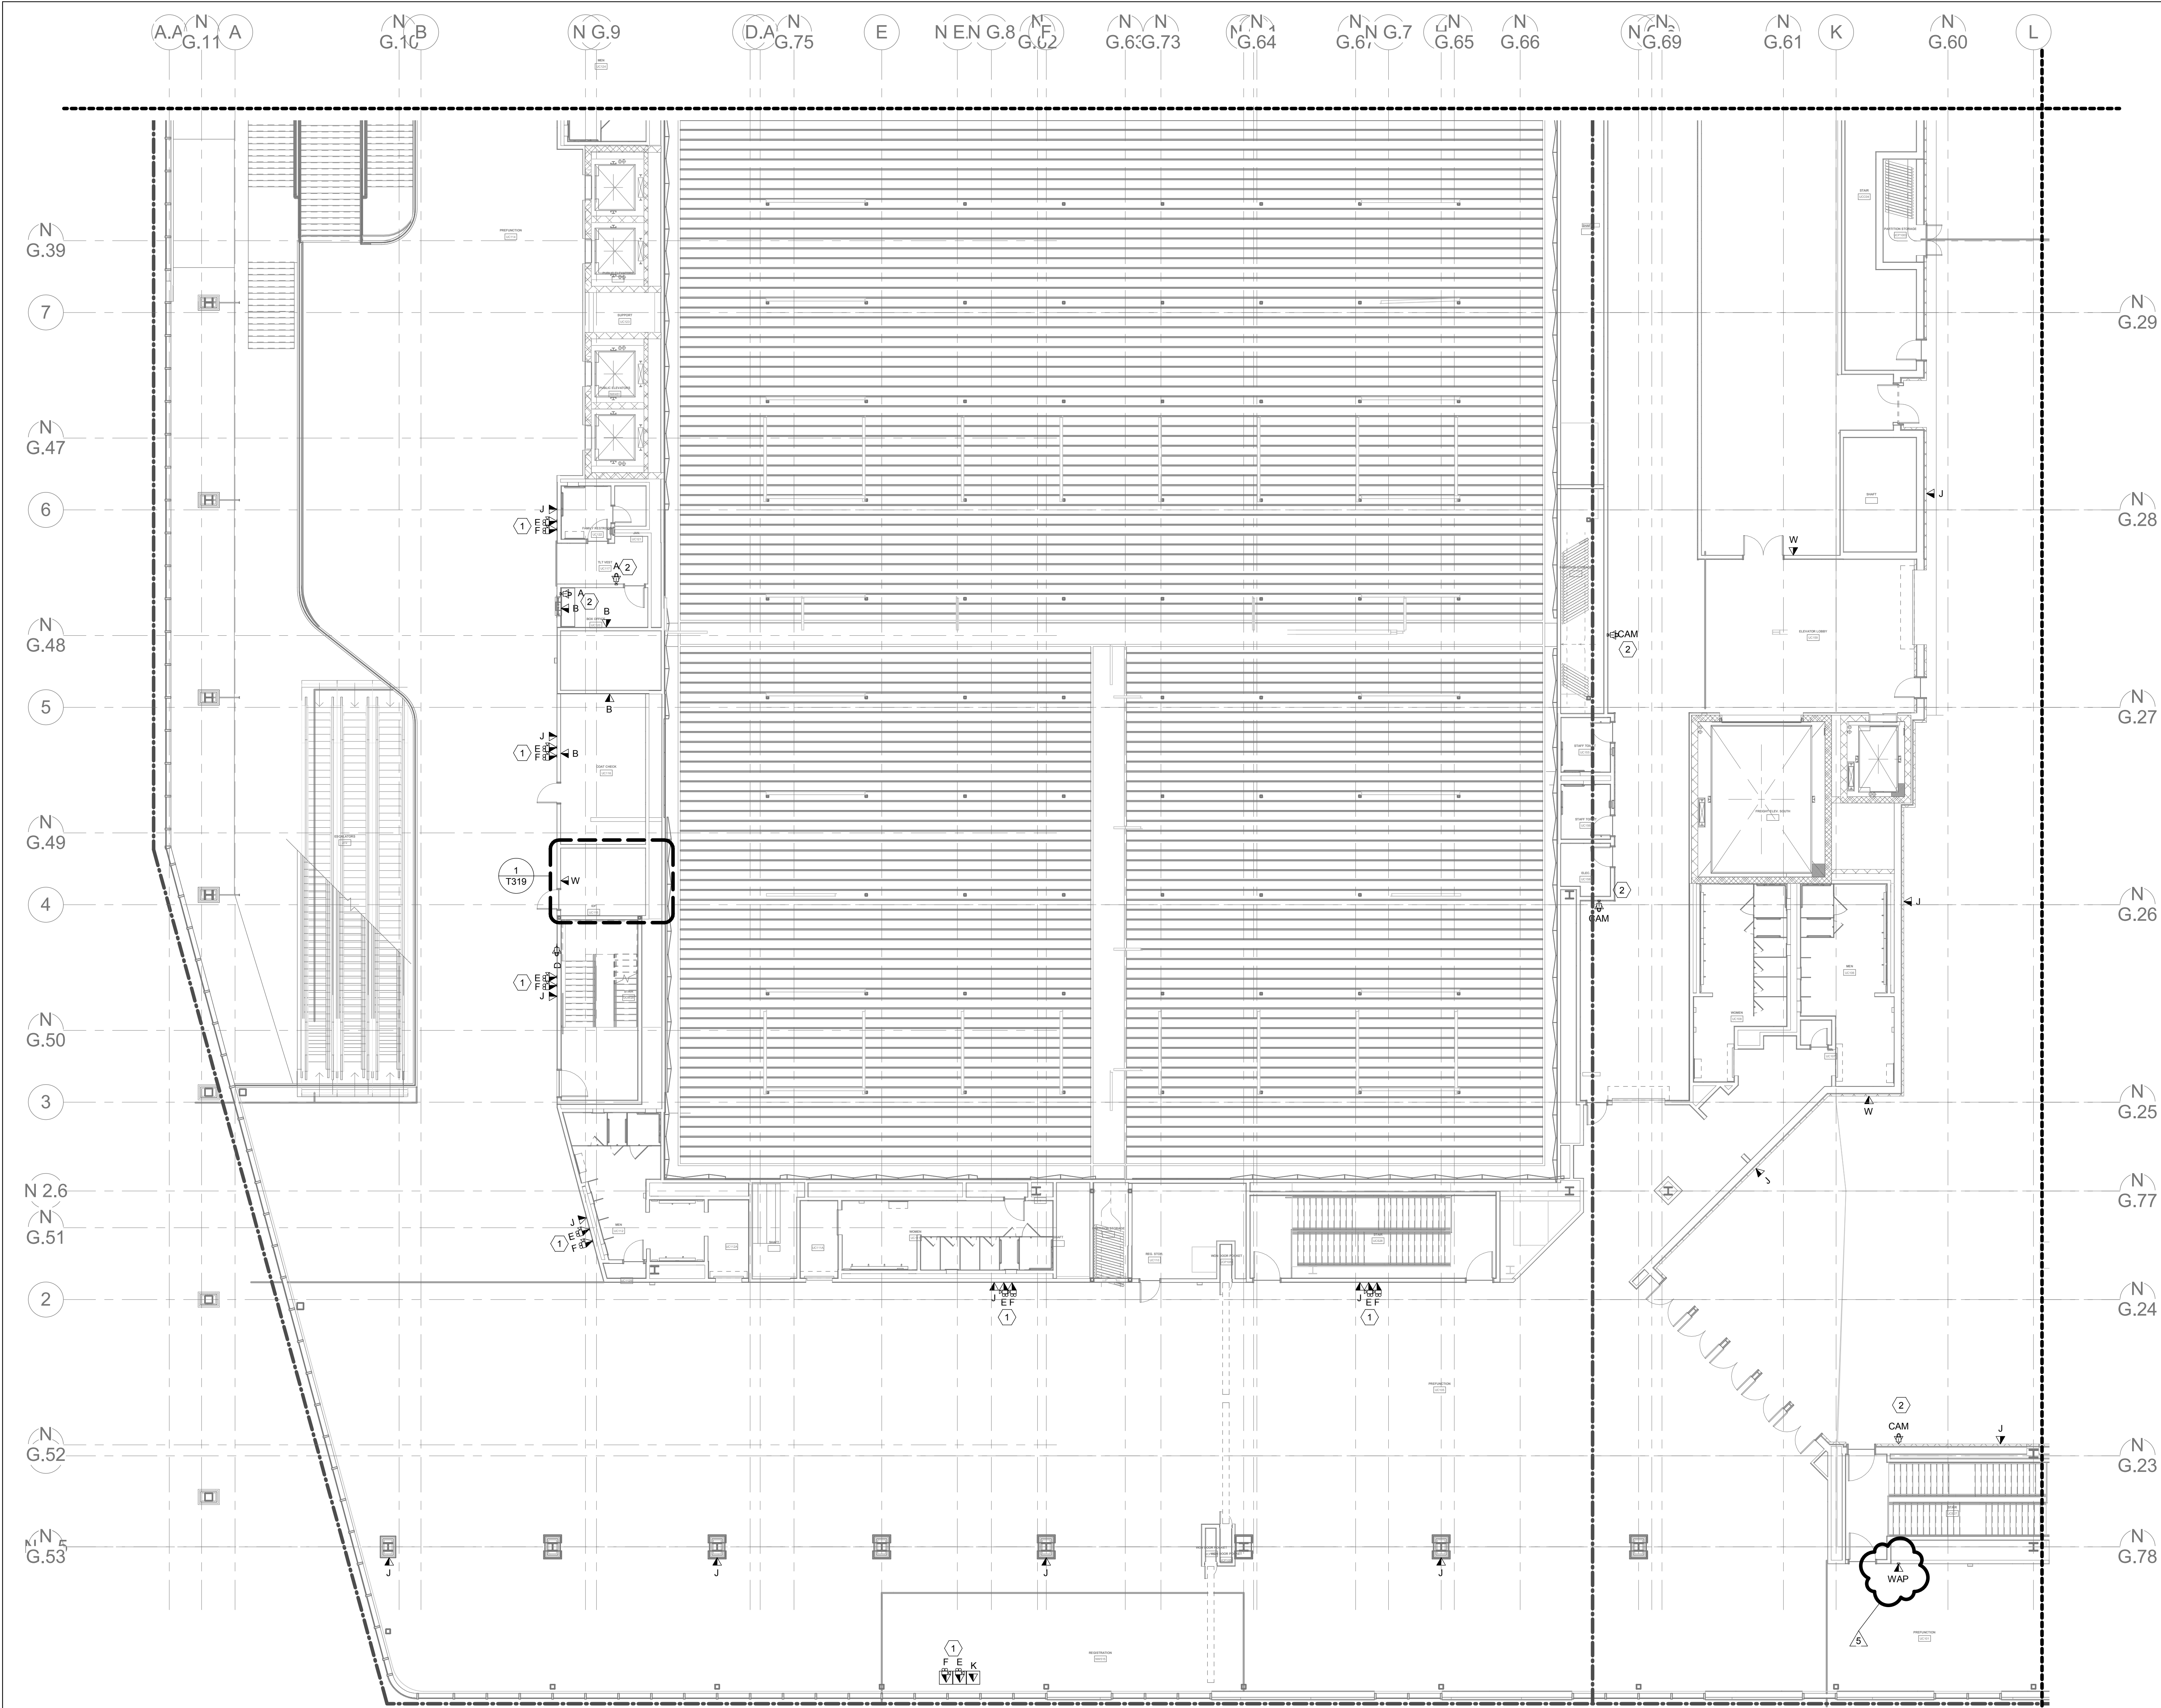




- SHEET NOTES (x)
1. REFER TO AV DRAWINGS FOR ADDITIONAL INFORMATION
 2. REFER TO SECURITY DRAWINGS FOR ADDITIONAL INFORMATION.

1 TELECOM UPPER CONCOURSE - AREA SW
3/32" = 1'-0"

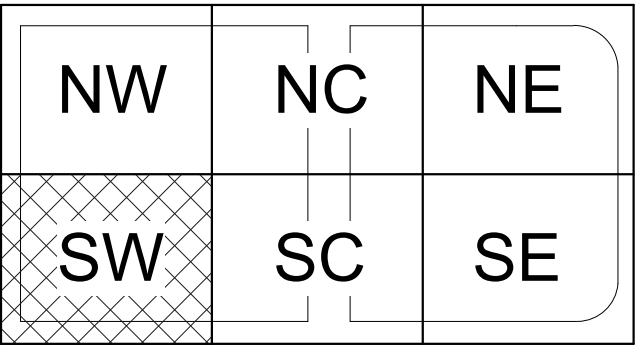KEYPLAN




DRAWING INFORMATION		KENTUCKY INTERNATIONAL CONVENTION CENTER RENOVATION AND EXPANSION				
A&E FILE NO.	14.03019.00	TELECOM UPPER CONCOURSE - AREA SW		DRAWING NO.		
DRAWING DATE	09/19/16	<div>ACCOUNT NO. 235 C77K</div> <div>COMMONWEALTH OF KENTUCKY FINANCE AND ADMINISTRATION CABINET DEPARTMENT FOR FACILITIES & SUPPORT SERVICES DIVISION OF ENGINEERING AND CONTRACT ADMINISTRATION FRANKFORT, KENTUCKY</div> <div></div> <div>architecture interiors</div>		T120B		
DRAWN BY	RZ			AS BUILT DATE		
CHECKED BY	JF			DECA LOG #		
PHASE	D					
RTA DATE						
 <div>SM&W</div> <div>SHEN MILSON WILKE</div>		REVISION HISTORY OF THIS DRAWING				
		DESCRIPTION OF REVISIONS		DATE	DESCRIPTION OF REVISIONS	DATE
		100	CONSOLIDATED CONSTRUCTION SET	05/22/17		
		101	PR#	9/20/2017		

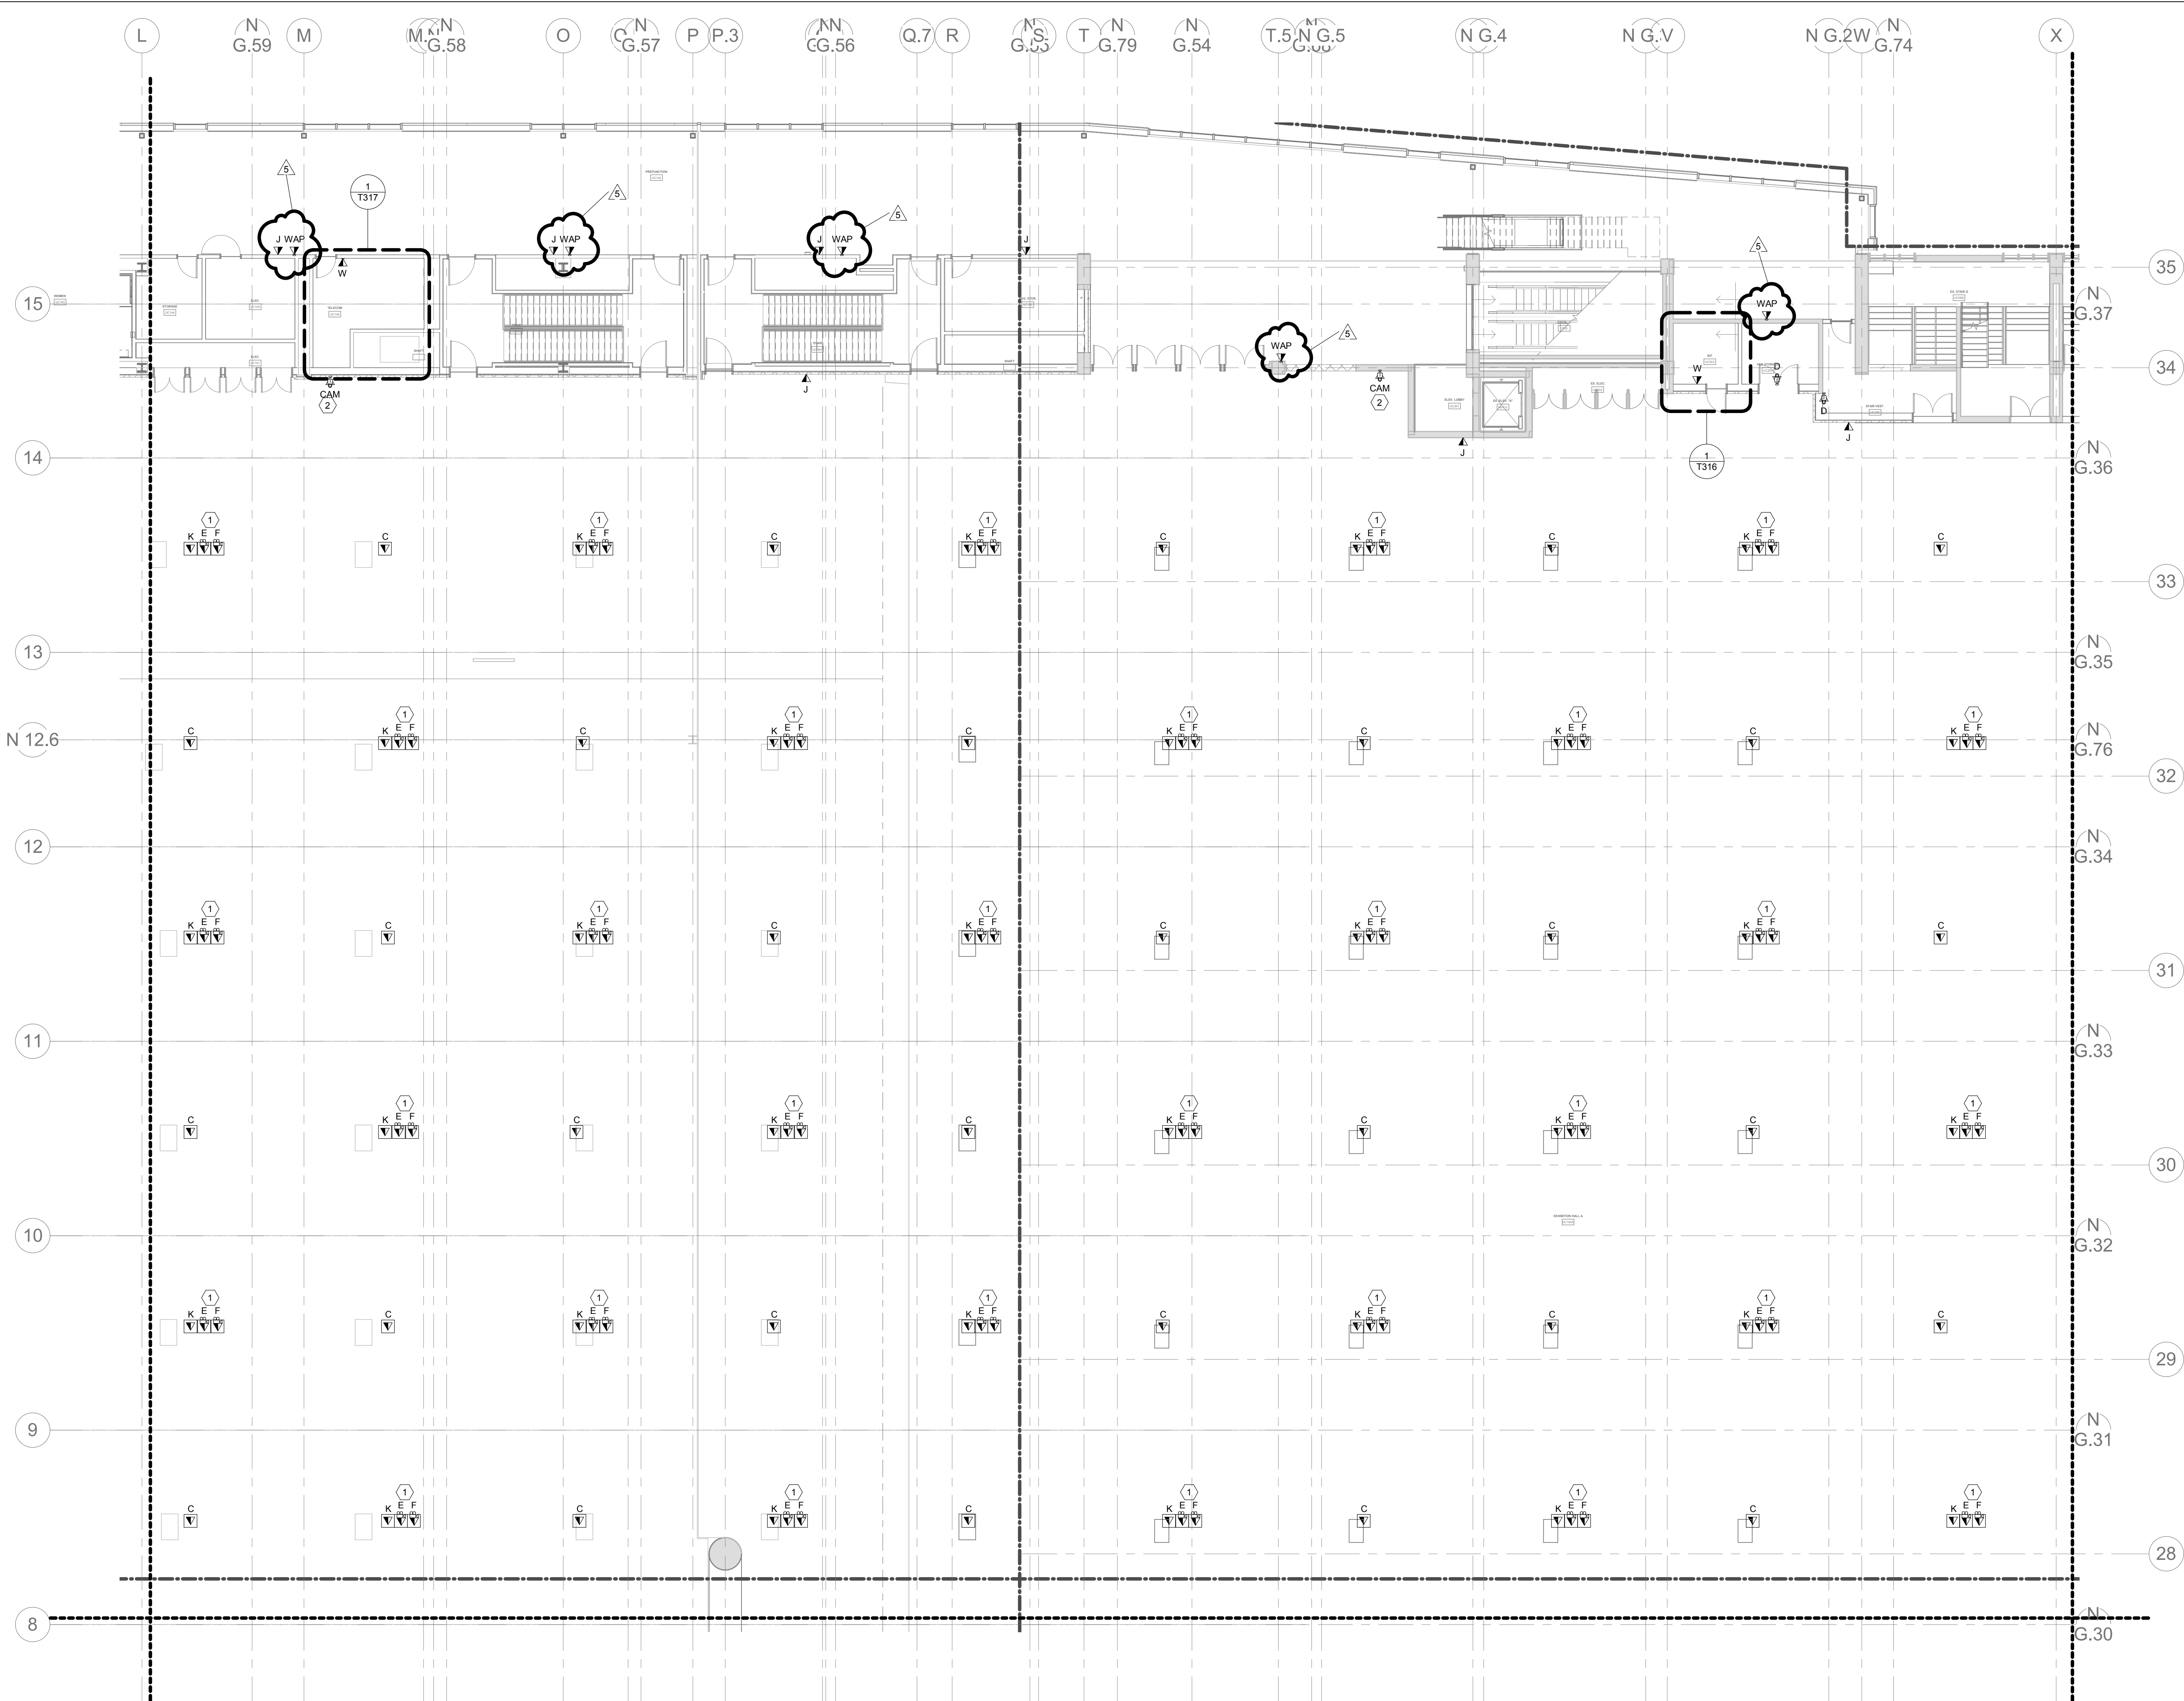


- SHEET NOTES: (#)
1. REFER TO AV DRAWINGS FOR ADDITIONAL INFORMATION
 2. REFER TO SECURITY DRAWINGS FOR ADDITIONAL INFORMATION.


1 TELECOM UPPER CONCOURSE - AREA NC
3/32" = 1'-0"

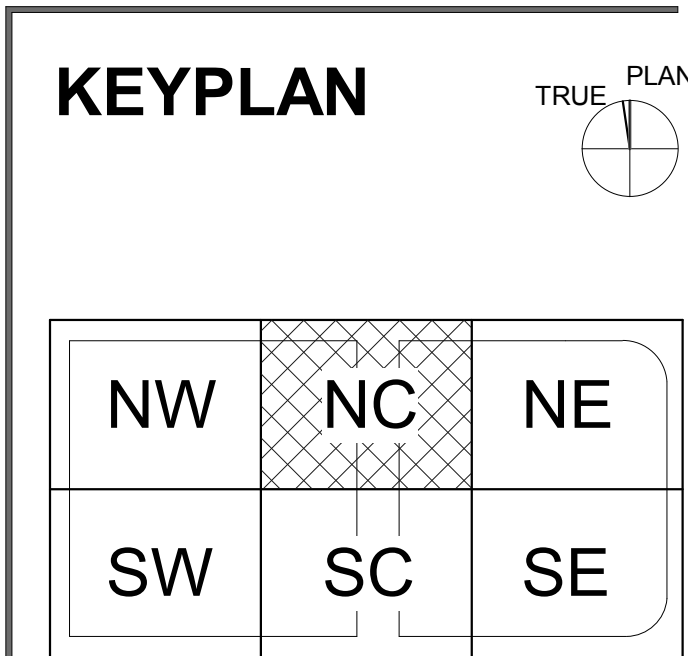

DRAWING INFORMATION	
A&E FILE NO.	14.03019.00
DRAWING DATE	09/19/16
DRAWN BY	RZ
CHECKED BY	JF
RTA DATE	D





KENTUCKY INTERNATIONAL CONVENTION CENTER RENOVATION AND EXPANSION					DRAWING NO.
TELECOM UPPER CONCOURSE - AREA NC					T120C
ACCOUNT NO.	COMMONWEALTH OF KENTUCKY FINANCE AND ADMINISTRATION CABINET DEPARTMENT FOR FACILITIES & SUPPORT SERVICES DIVISION OF ENGINEERING AND CONTRACT ADMINISTRATION FRANKFORT, KENTUCKY				
235 C77K					AS BUILT DATE
REVISION HISTORY OF THIS DRAWING					DECA LOG #
DESCRIPTION OF REVISIONS		DATE	DESCRIPTION OF REVISIONS		DATE
00	CONSOLIDATED CONSTRUCTION SET	05/22/17			
01	PR#	9/20/2017			

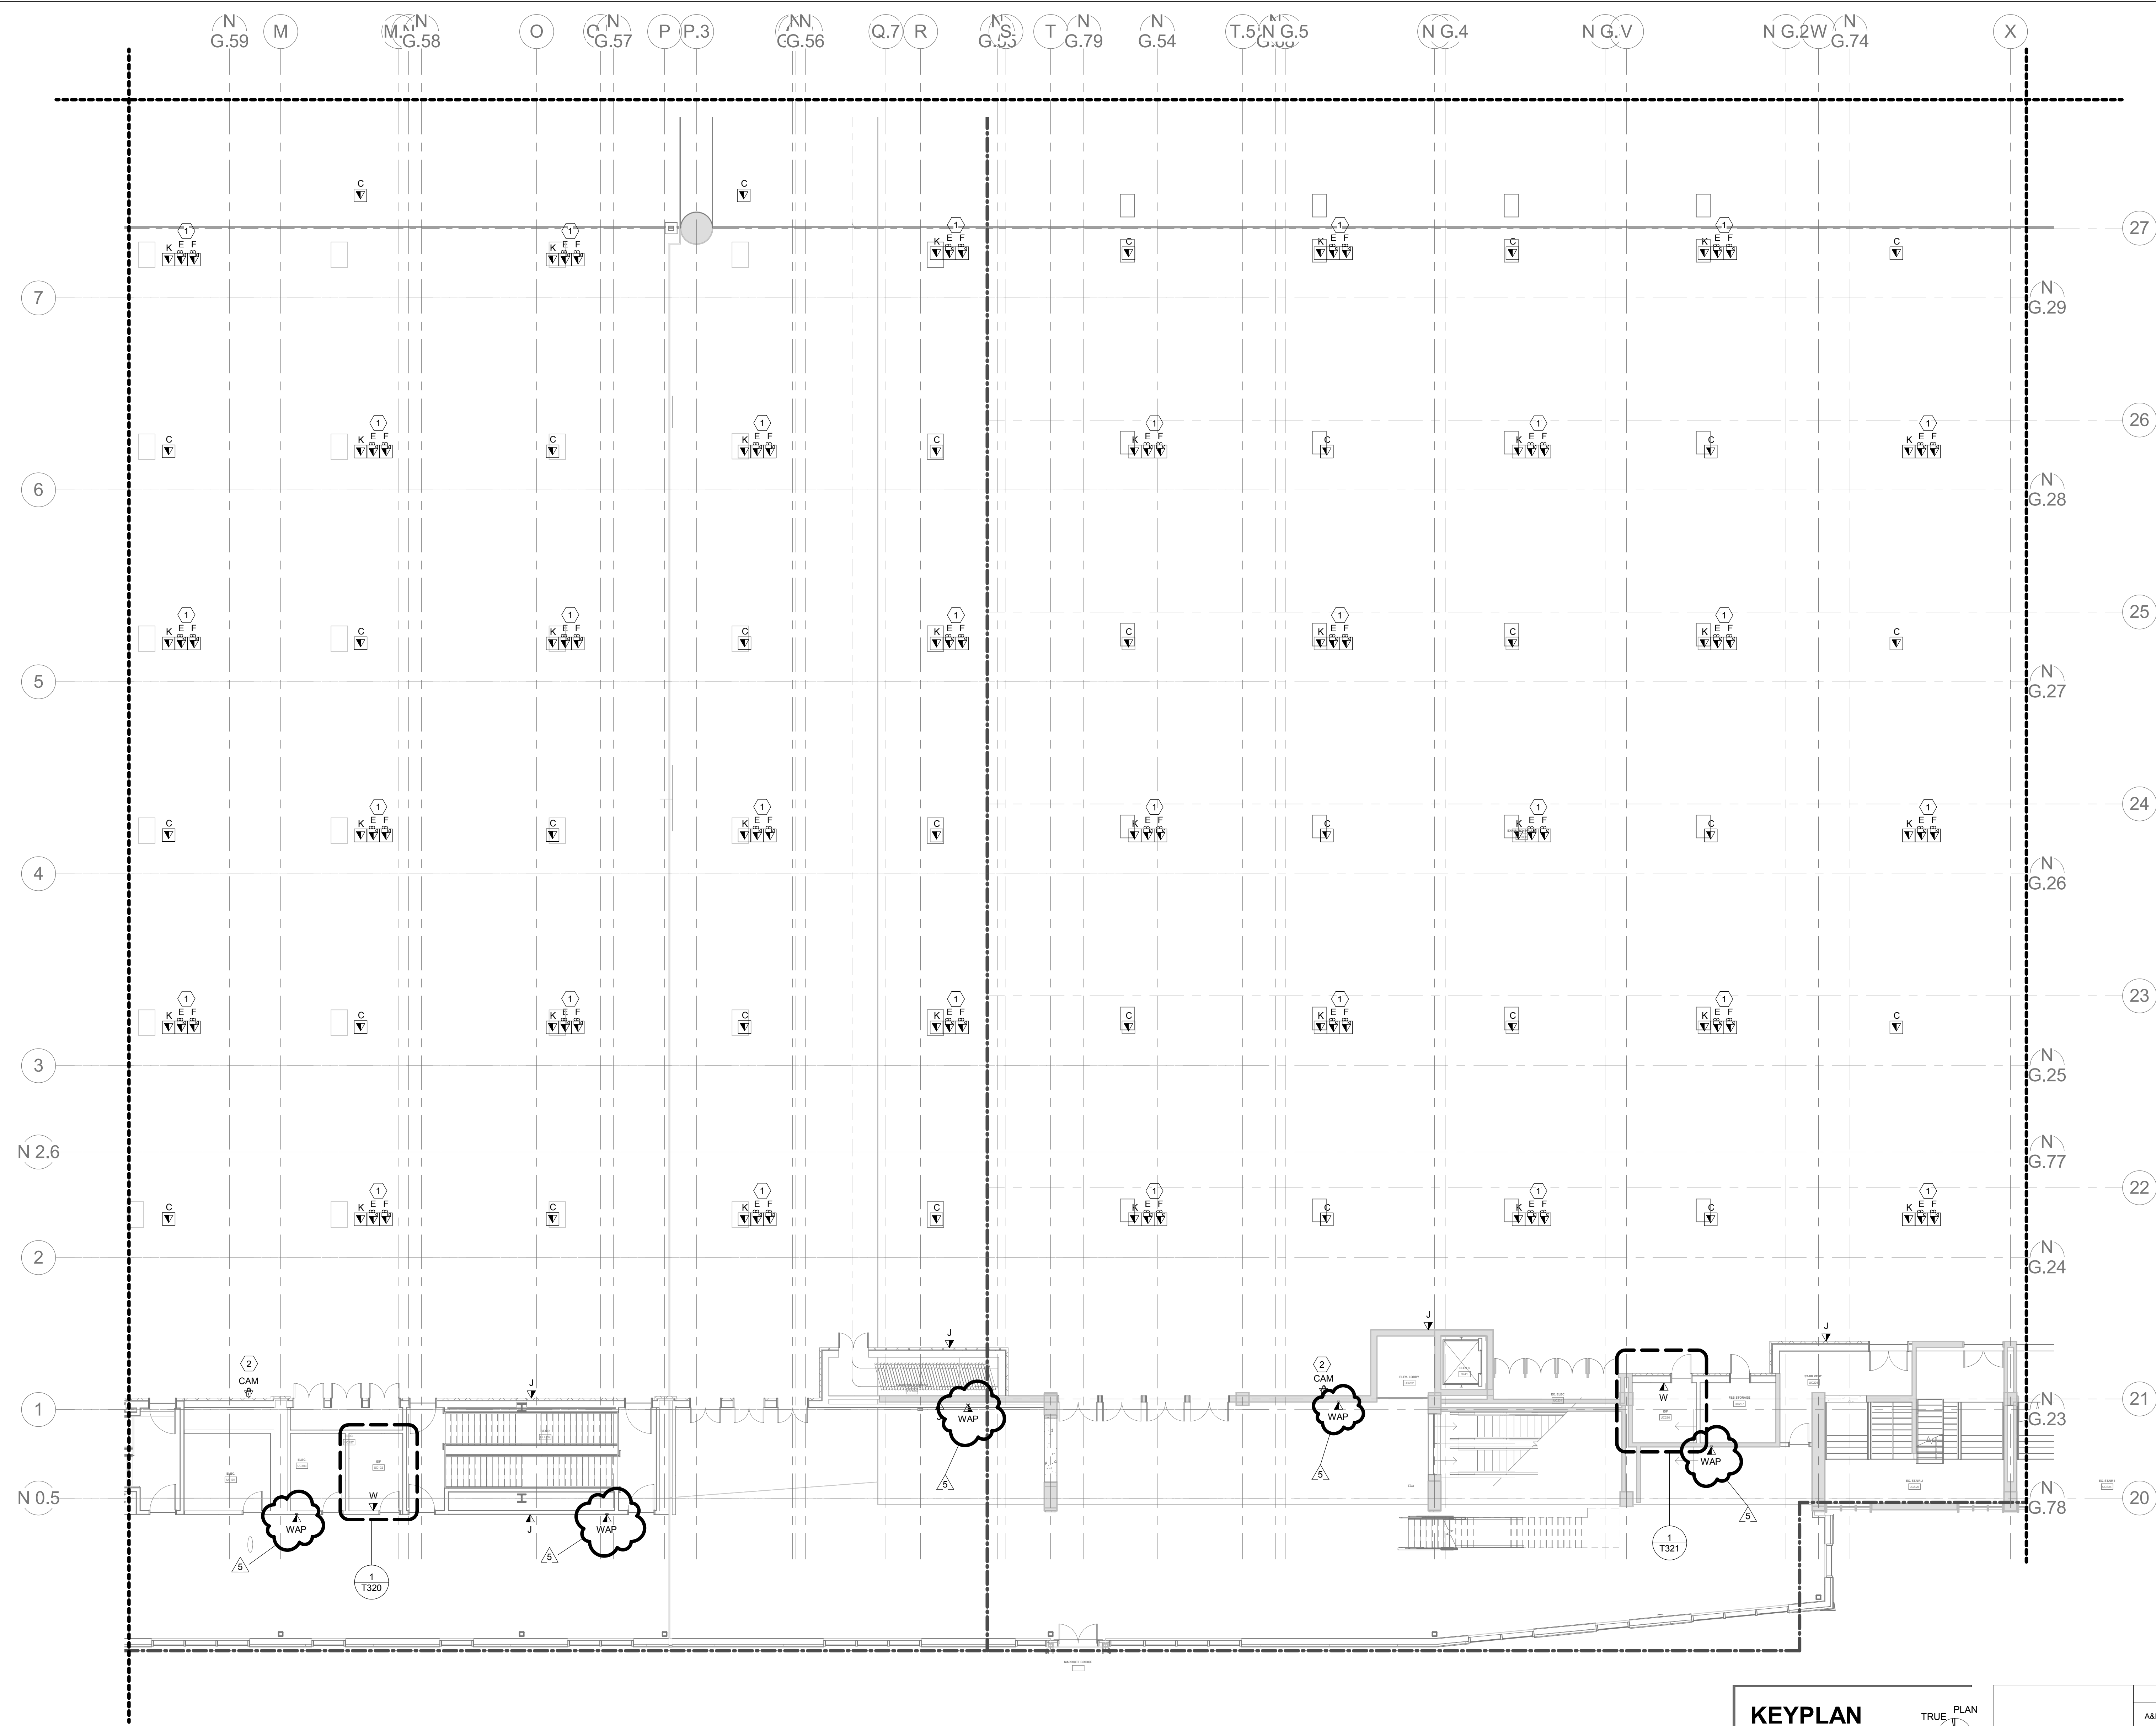




- SHEET NOTES: (#)
1. REFER TO AV DRAWINGS FOR ADDITIONAL INFORMATION
 2. REFER TO SECURITY DRAWINGS FOR ADDITIONAL INFORMATION.

1 TELECOM UPPER CONCOURSE - AREA SC
3/32" = 1'-0"

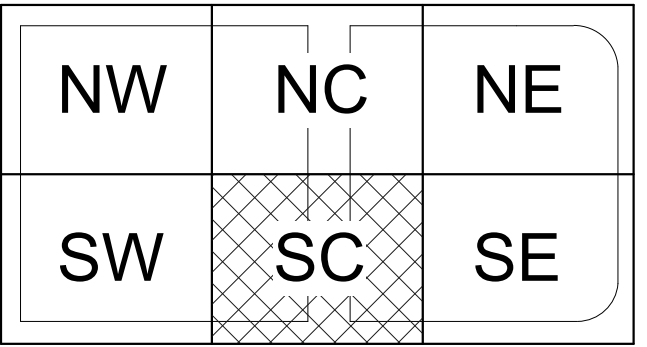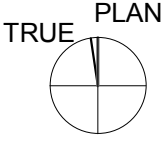KEYPLAN



DRAWING INFORMATION		KENTUCKY INTERNATIONAL CONVENTION CENTER RENOVATION AND EXPANSION					
A&E FILE NO.	14.03019.00	TELECOM UPPER CONCOURSE - AREA SC			DRAWING NO.		
DRAWING DATE	09/19/16	COMMONWEALTH OF KENTUCKY FINANCE AND ADMINISTRATION CABINET DEPARTMENT FOR FACILITIES & SUPPORT SERVICES DIVISION OF ENGINEERING AND CONTRACT ADMINISTRATION FRANKFORT, KENTUCKY			T120D		
DRAWN BY	RZ						
CHECKED BY	JF						
PHASE	D						
RTA DATE					AS BUILT DATE		
					DECA LOG #		
					REVISION HISTORY OF THIS DRAWING		
					DESCRIPTION OF REVISIONS		DATE
		100	CONSOLIDATED CONSTRUCTION SET	05/22/17			
		101	PR#	9/20/2017			

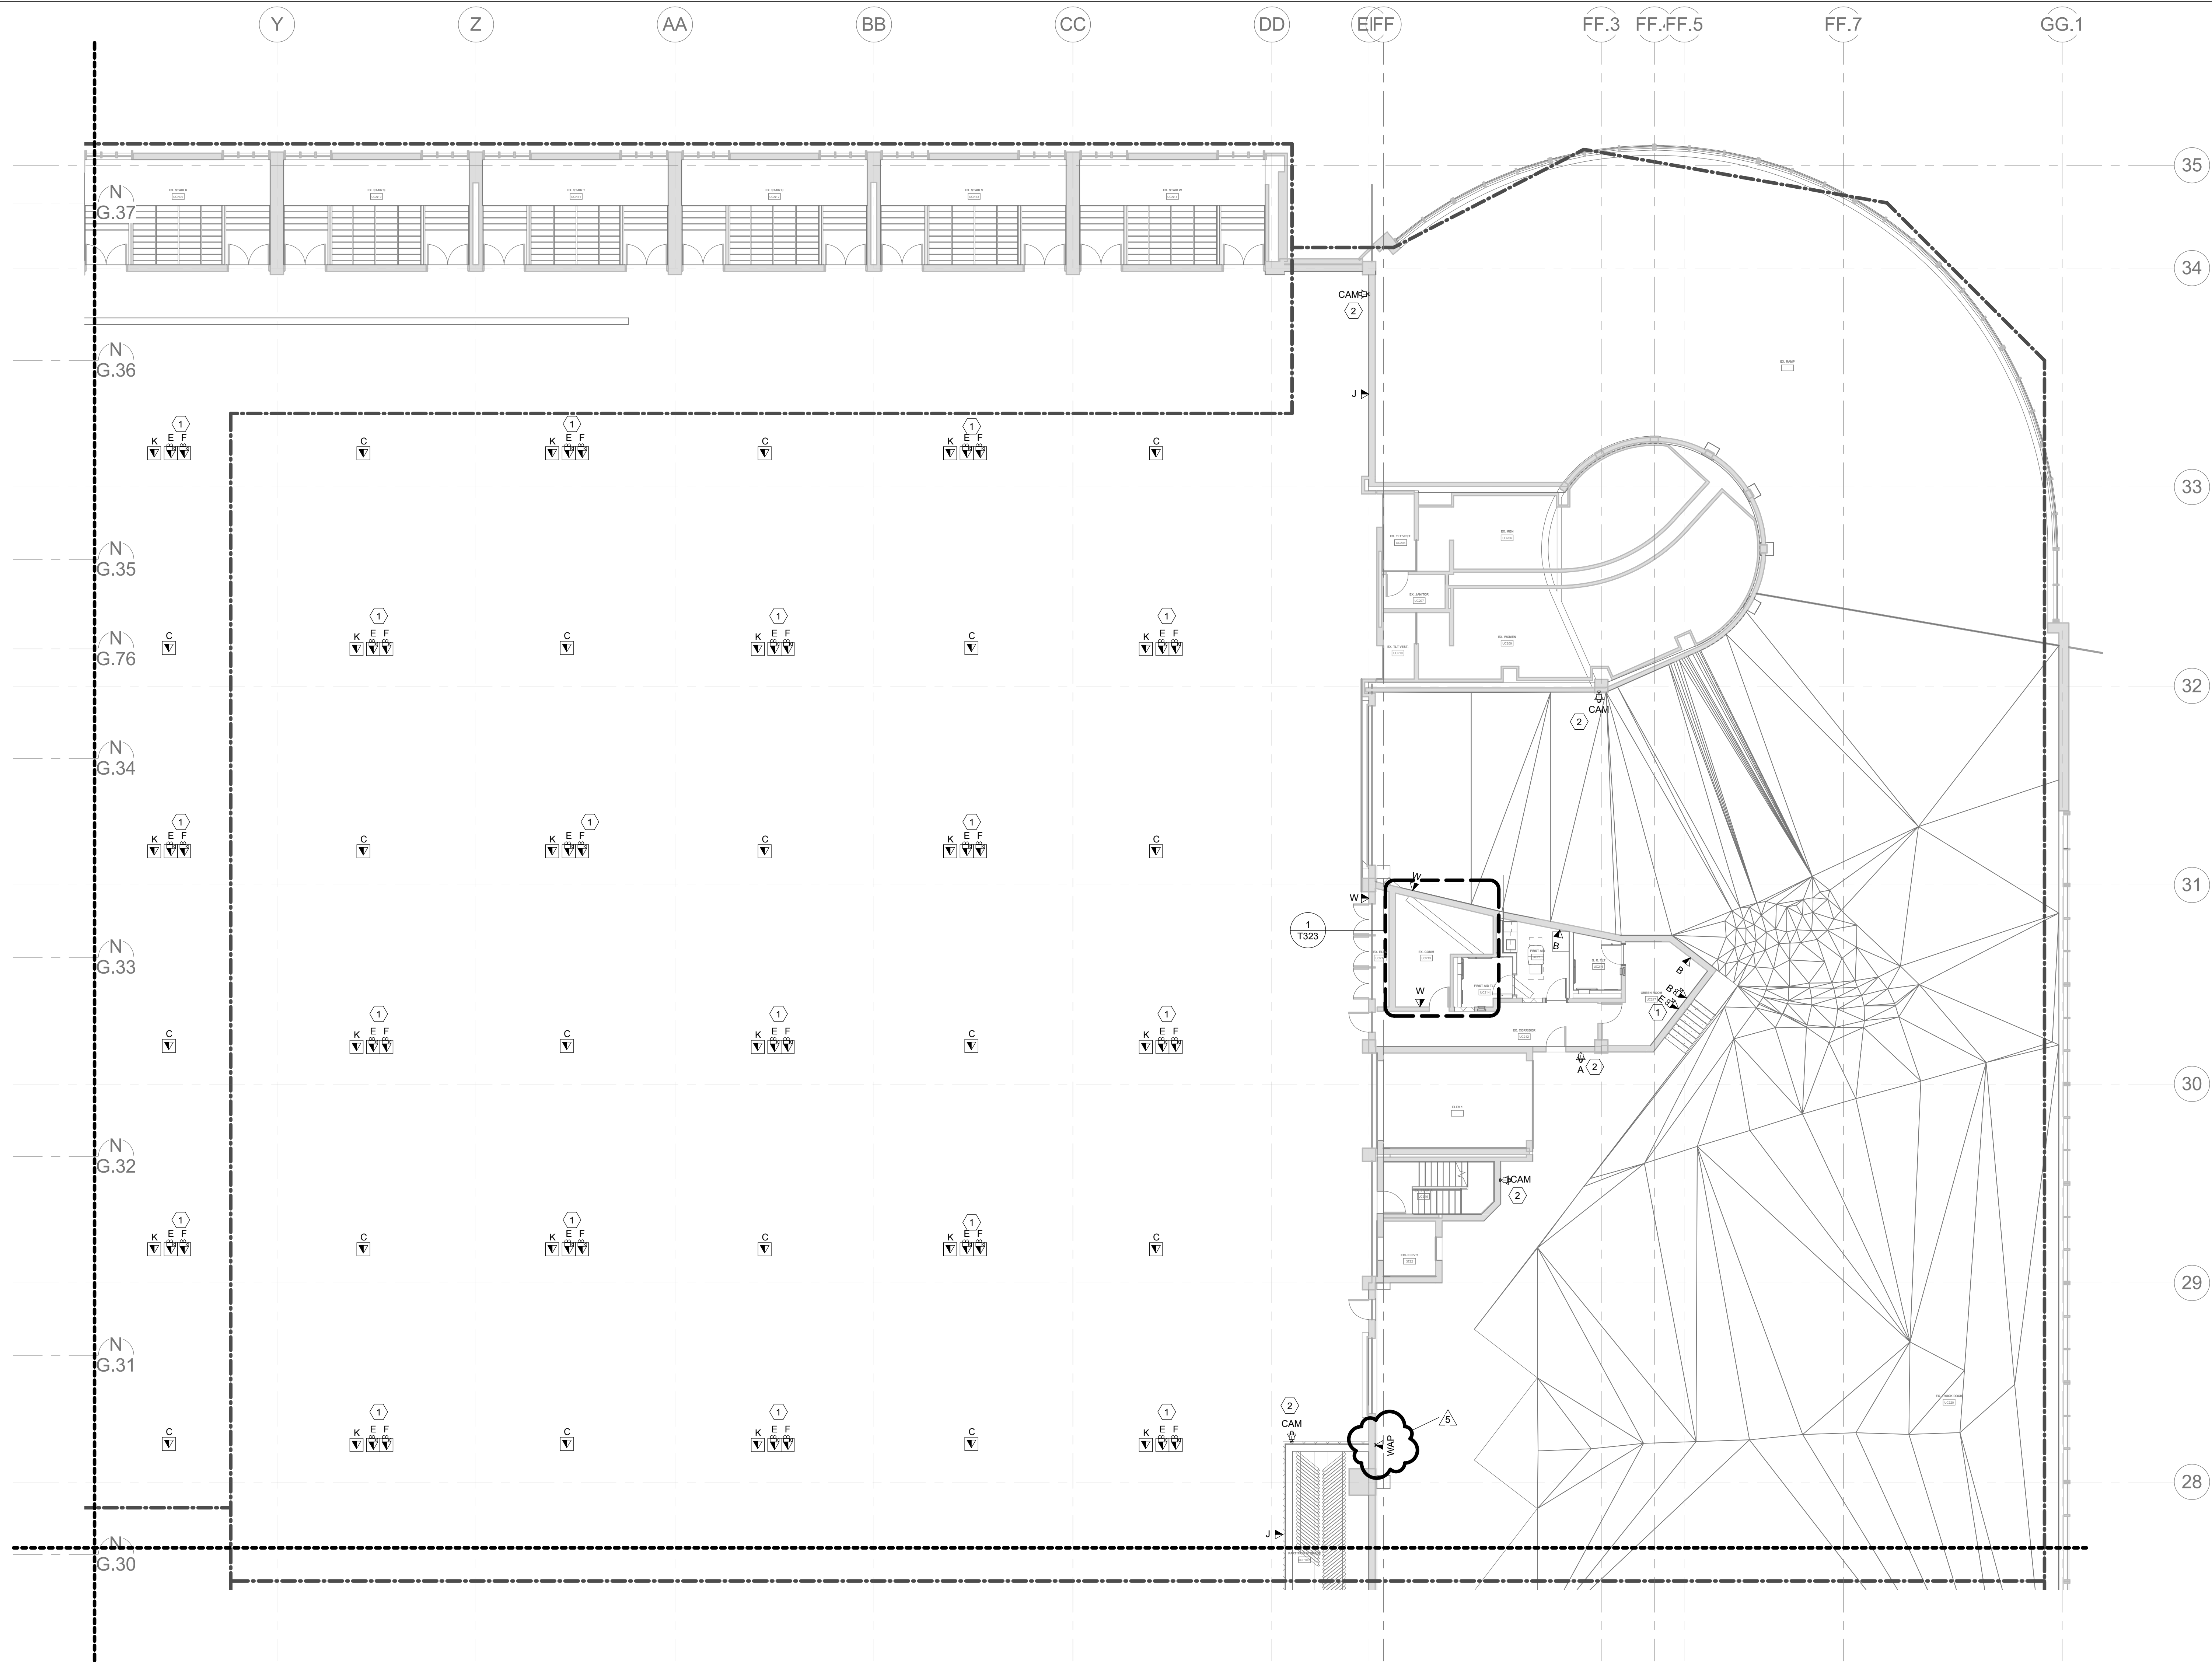




- SHEET NOTES: (#)
1. REFER TO AV DRAWINGS FOR ADDITIONAL INFORMATION
 2. REFER TO SECURITY DRAWINGS FOR ADDITIONAL INFORMATION.

1 TELECOM UPPER CONCOURSE - AREA NE
3/32" = 1'-0"

KEYPLAN


NW	NC	NE
SW	SC	SE

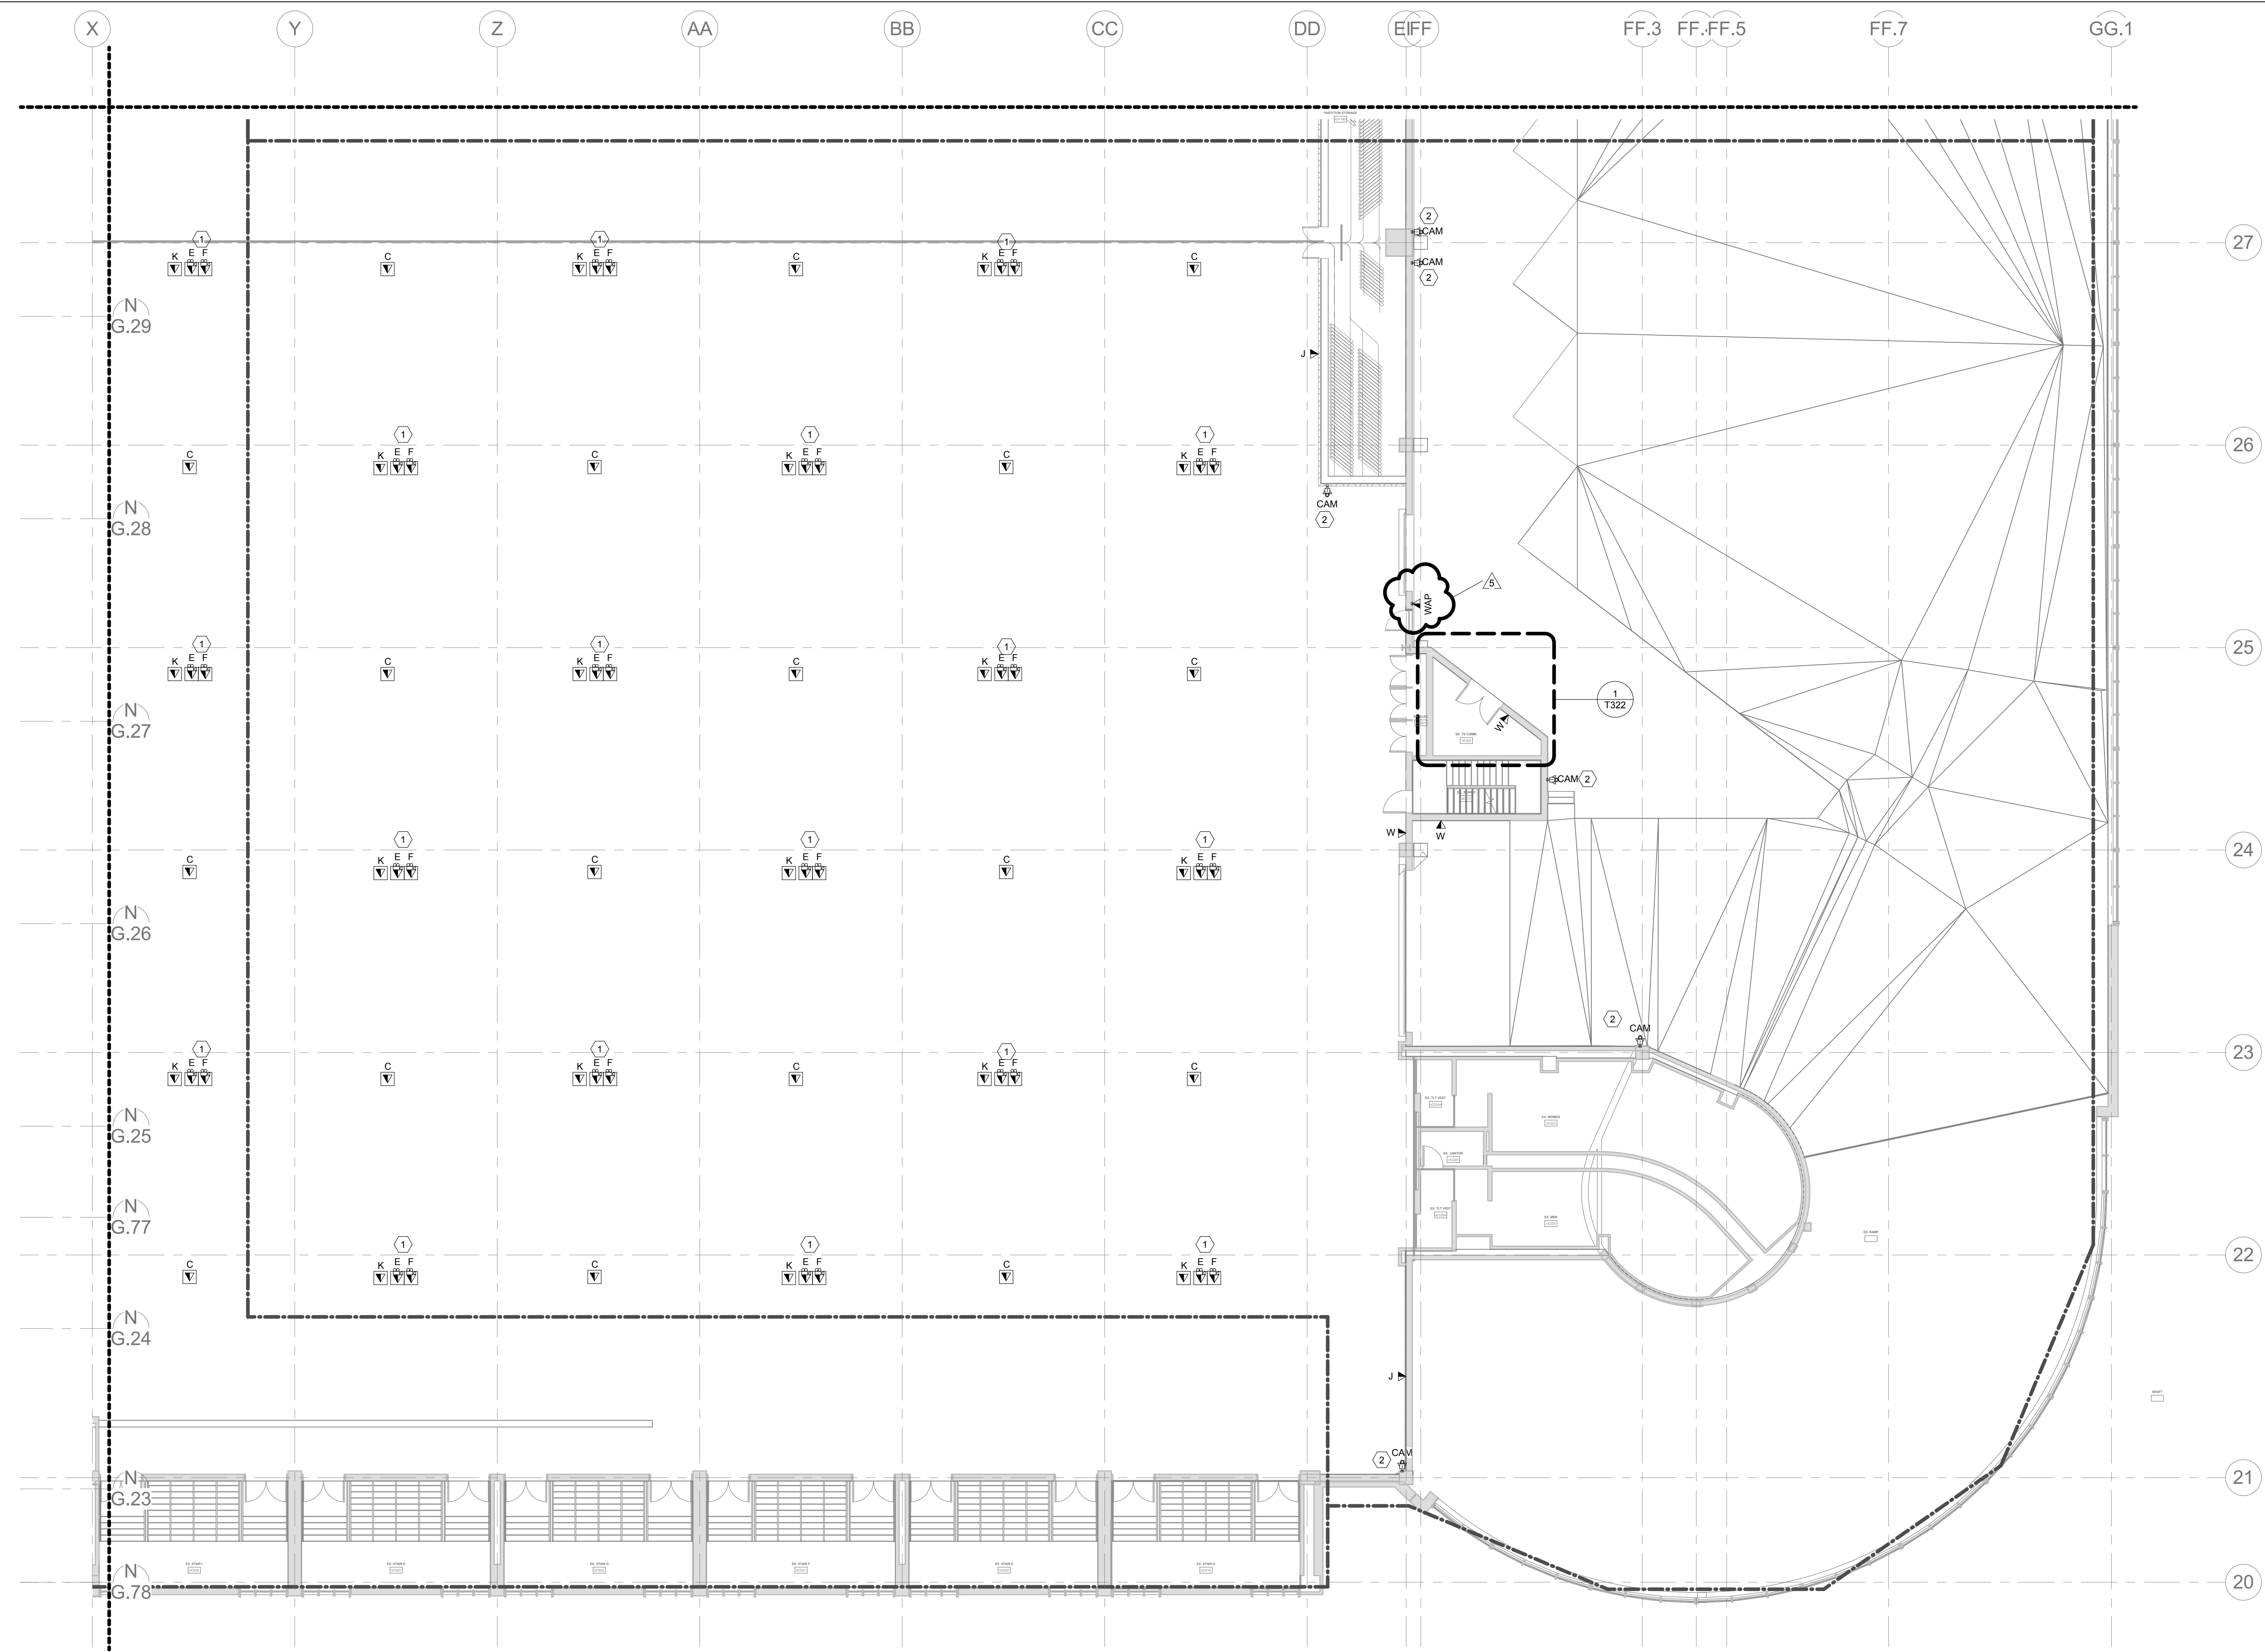

DRAWING INFORMATION		KENTUCKY INTERNATIONAL CONVENTION CENTER RENOVATION AND EXPANSION			
A&E FILE NO.	14.03019.00	TELECOM UPPER CONCOURSE - AREA NE		DRAWING NO.	
DRAWING DATE	09/19/16			T120E	
DRAWN BY	RZ				
CHECKED BY	JF			AS BUILT DATE	
PHASE	D			DECA LOG #	
RTA DATE					
 SHEN MILSOM WILKE		REVISION HISTORY OF THIS DRAWING			
		DESCRIPTION OF REVISIONS		DATE	DATE
		100 CONSOLIDATED CONSTRUCTION SET		05/22/17	
		101 PR#		9/20/2017	




- SHEET NOTES: (#)
1. REFER TO AV DRAWINGS FOR ADDITIONAL INFORMATION
 2. REFER TO SECURITY DRAWINGS FOR ADDITIONAL INFORMATION.

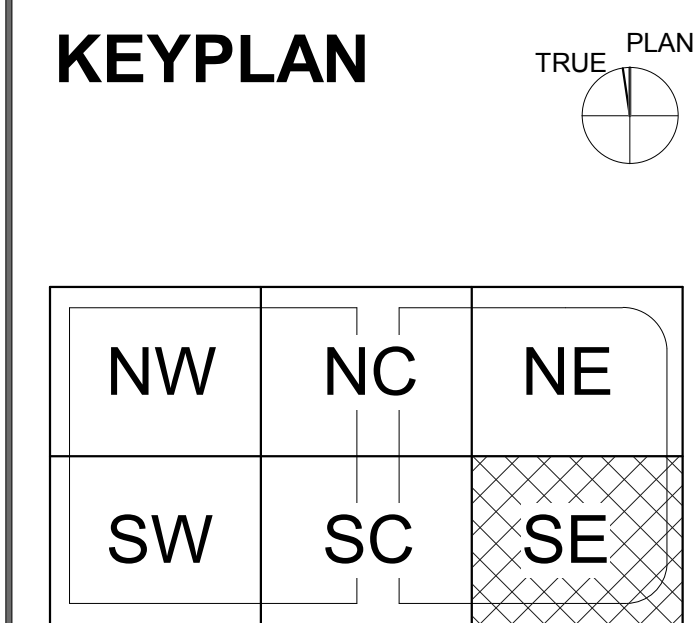1 TELECOM UPPER CONCOURSE - AREA SE
3/32" = 1'-0"



DRAWING INFORMATION		KENTUCKY INTERNATIONAL CONVENTION CENTER RENOVATION AND EXPANSION			
A&E FILE NO.	14.03019.00	TELECOM UPPER CONCOURSE - AREA SE		DRAWING NO.	
DRAWING DATE	09/19/16	ACCOUNT NO. 235 C77K		COMMONWEALTH OF KENTUCKY FINANCE AND ADMINISTRATION CABINET DEPARTMENT FOR FACILITIES & SUPPORT SERVICES DIVISION OF ENGINEERING AND CONTRACT ADMINISTRATION FRANKFORT, KENTUCKY	
DRAWN BY	RZ				
CHECKED BY	JF				
PHASE	D			AS BUILT DATE	
RTA DATE					
 SHEN MILSOM WILKE		REVISION HISTORY OF THIS DRAWING		DRAWING NO.	
		DESCRIPTION OF REVISIONS		DATE	DESCRIPTION OF REVISIONS
		DATE			
100		CONSOLIDATED CONSTRUCTION SET		05/22/17	
101		PR#		9/20/2017	

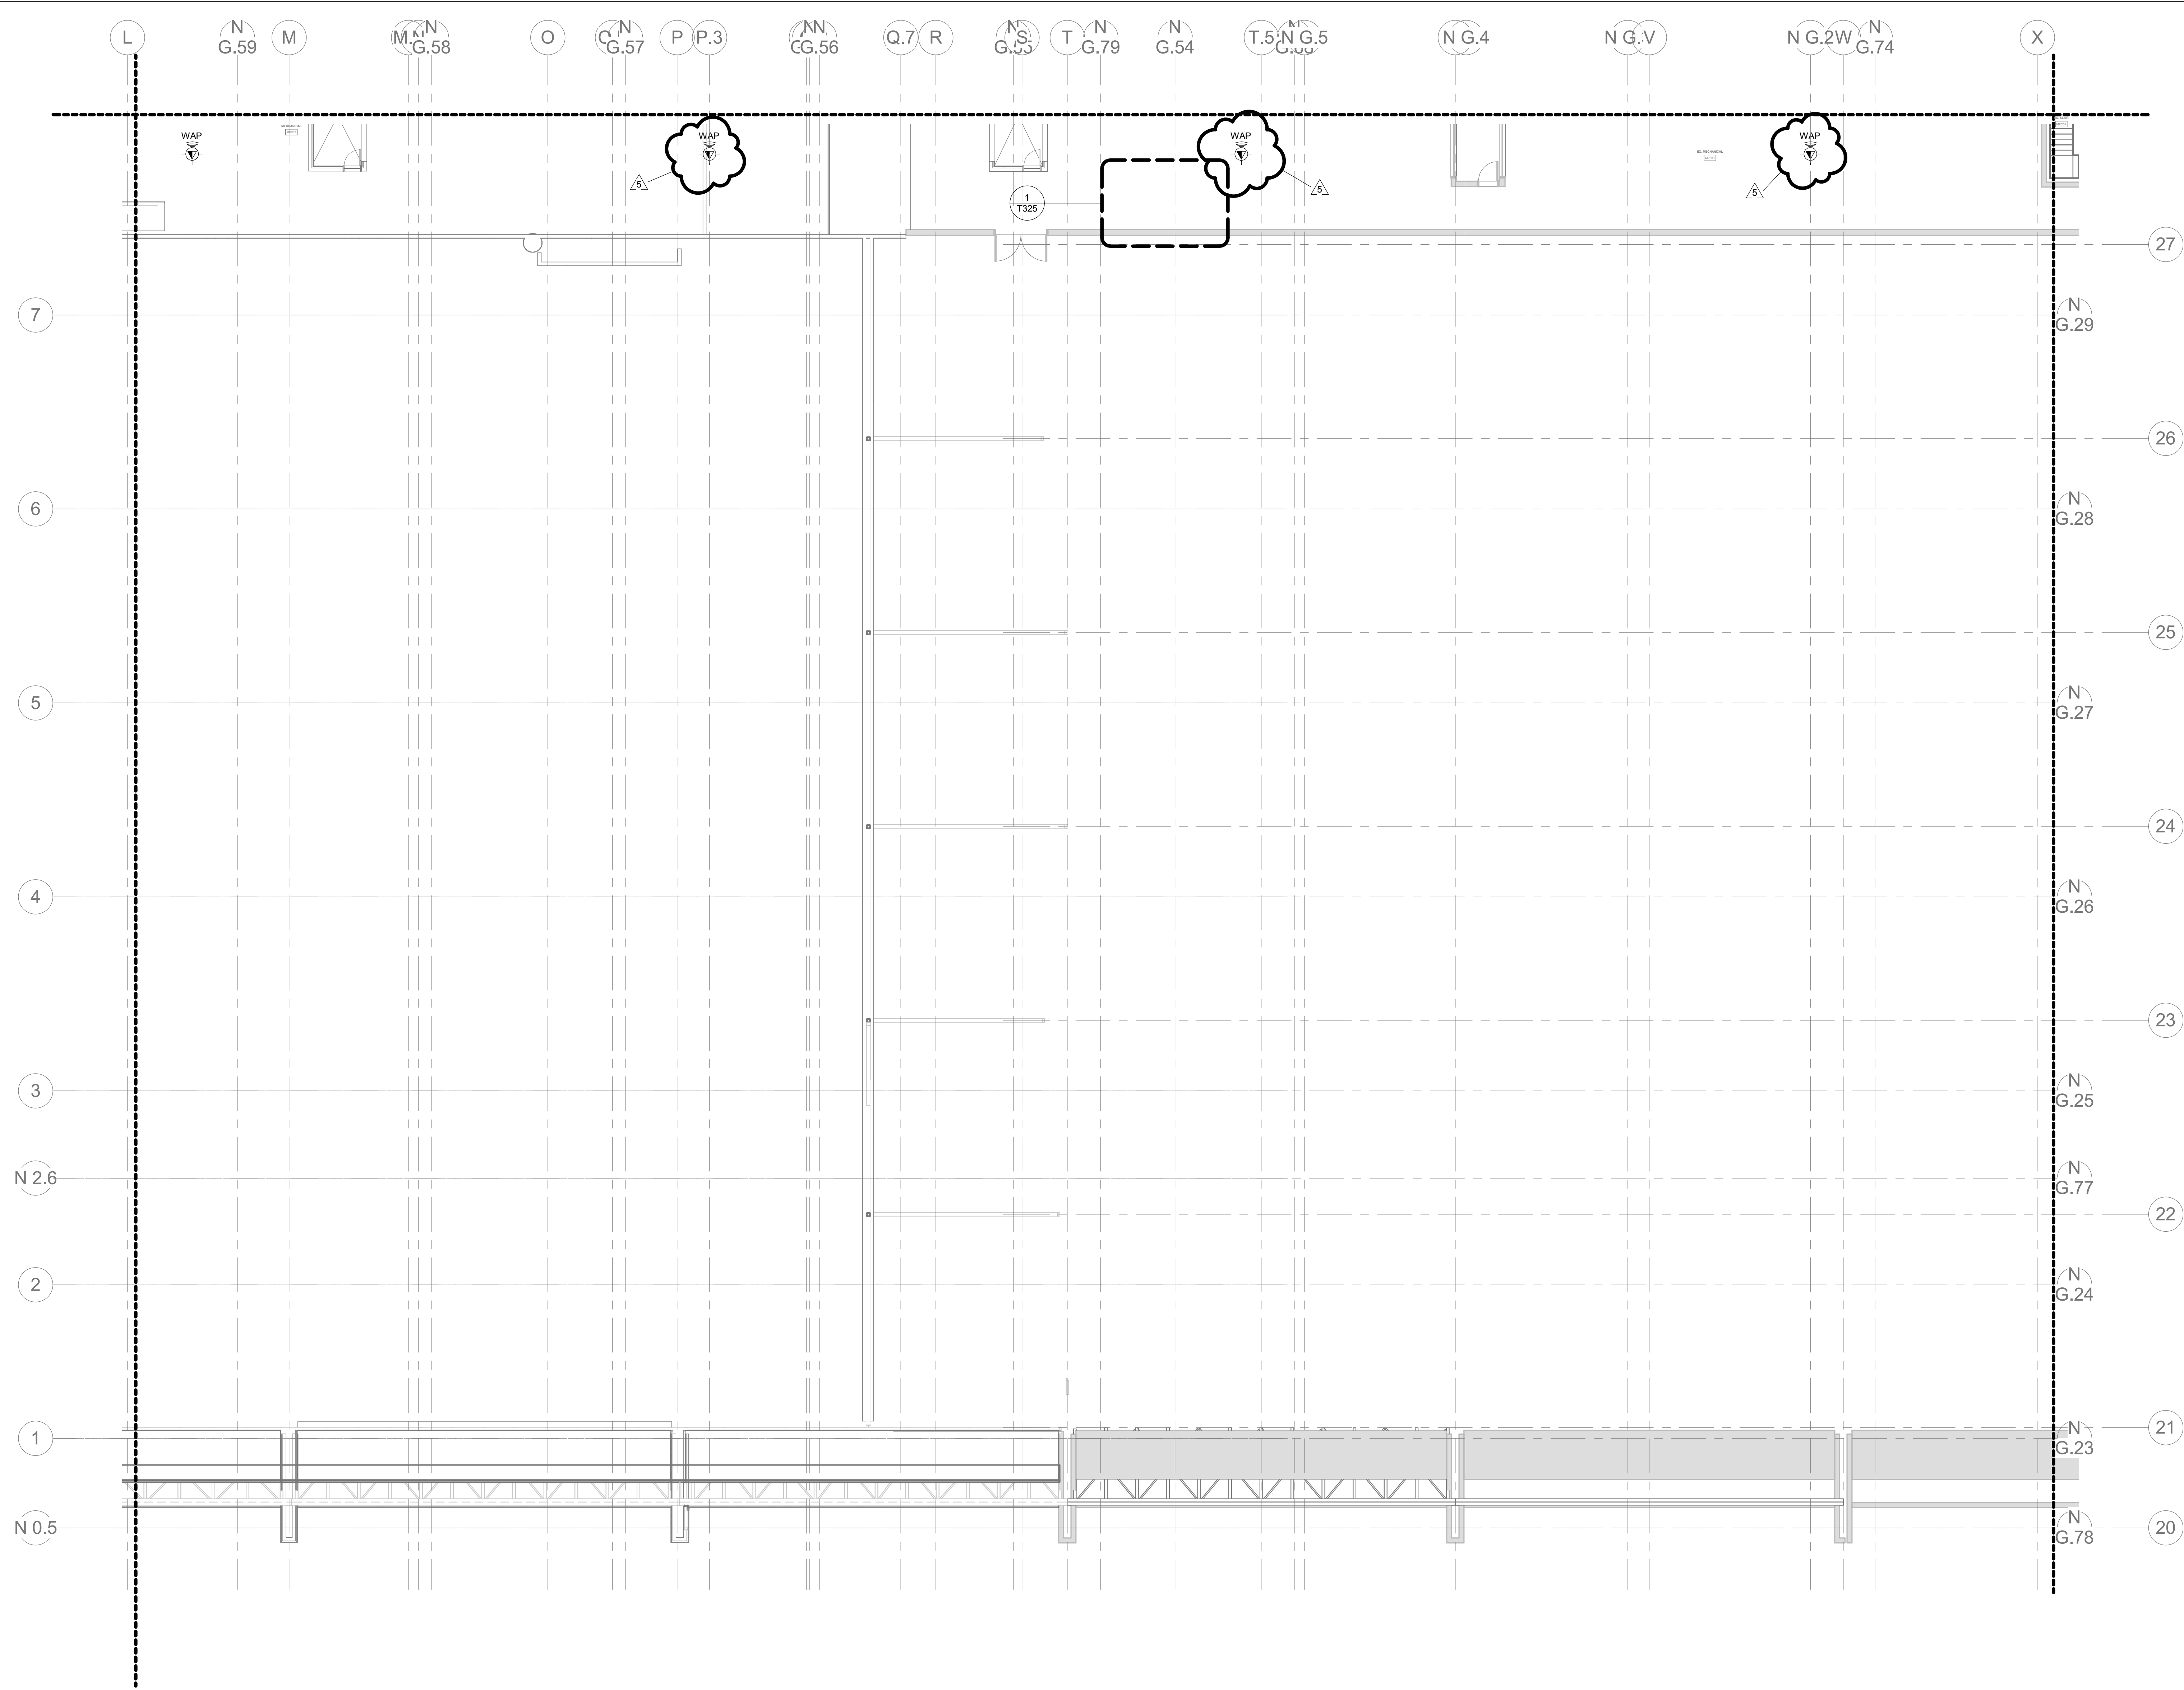

1 TELECOM MECHANICAL PENTHOUSE - AREA SC
3/32" = 1'-0"

KEYPLAN

TRUE PLAN

NW

NC


NE

SW

SC


SE

DRAWING INFORMATION		KENTUCKY INTERNATIONAL CONVENTION CENTER RENOVATION AND EXPANSION			
A&E FILE NO.	14.03019.00	TELECOM MECHANICAL PENTHOUSE - AREA SC		DRAWING NO.	
DRAWING DATE	09/19/16	ACCOUNT NO. 235 C77K		COMMONWEALTH OF KENTUCKY FINANCE AND ADMINISTRATION CABINET DEPARTMENT FOR FACILITIES & SUPPORT SERVICES DIVISION OF ENGINEERING AND CONTRACT ADMINISTRATION FRANKFORT, KENTUCKY	
DRAWN BY	RZ	<div><div>architecture interior</div><div>h+k</div></div>		AS BUILT DATE	
CHECKED BY	JF			DECA LOG #	
PHASE	D				
RTA DATE					
DESCRIPTION OF REVISIONS		DATE		DESCRIPTION OF REVISIONS	
100	CONSOLIDATED CONSTRUCTION SET	05/22/17			
101	PR#	9/20/2017			

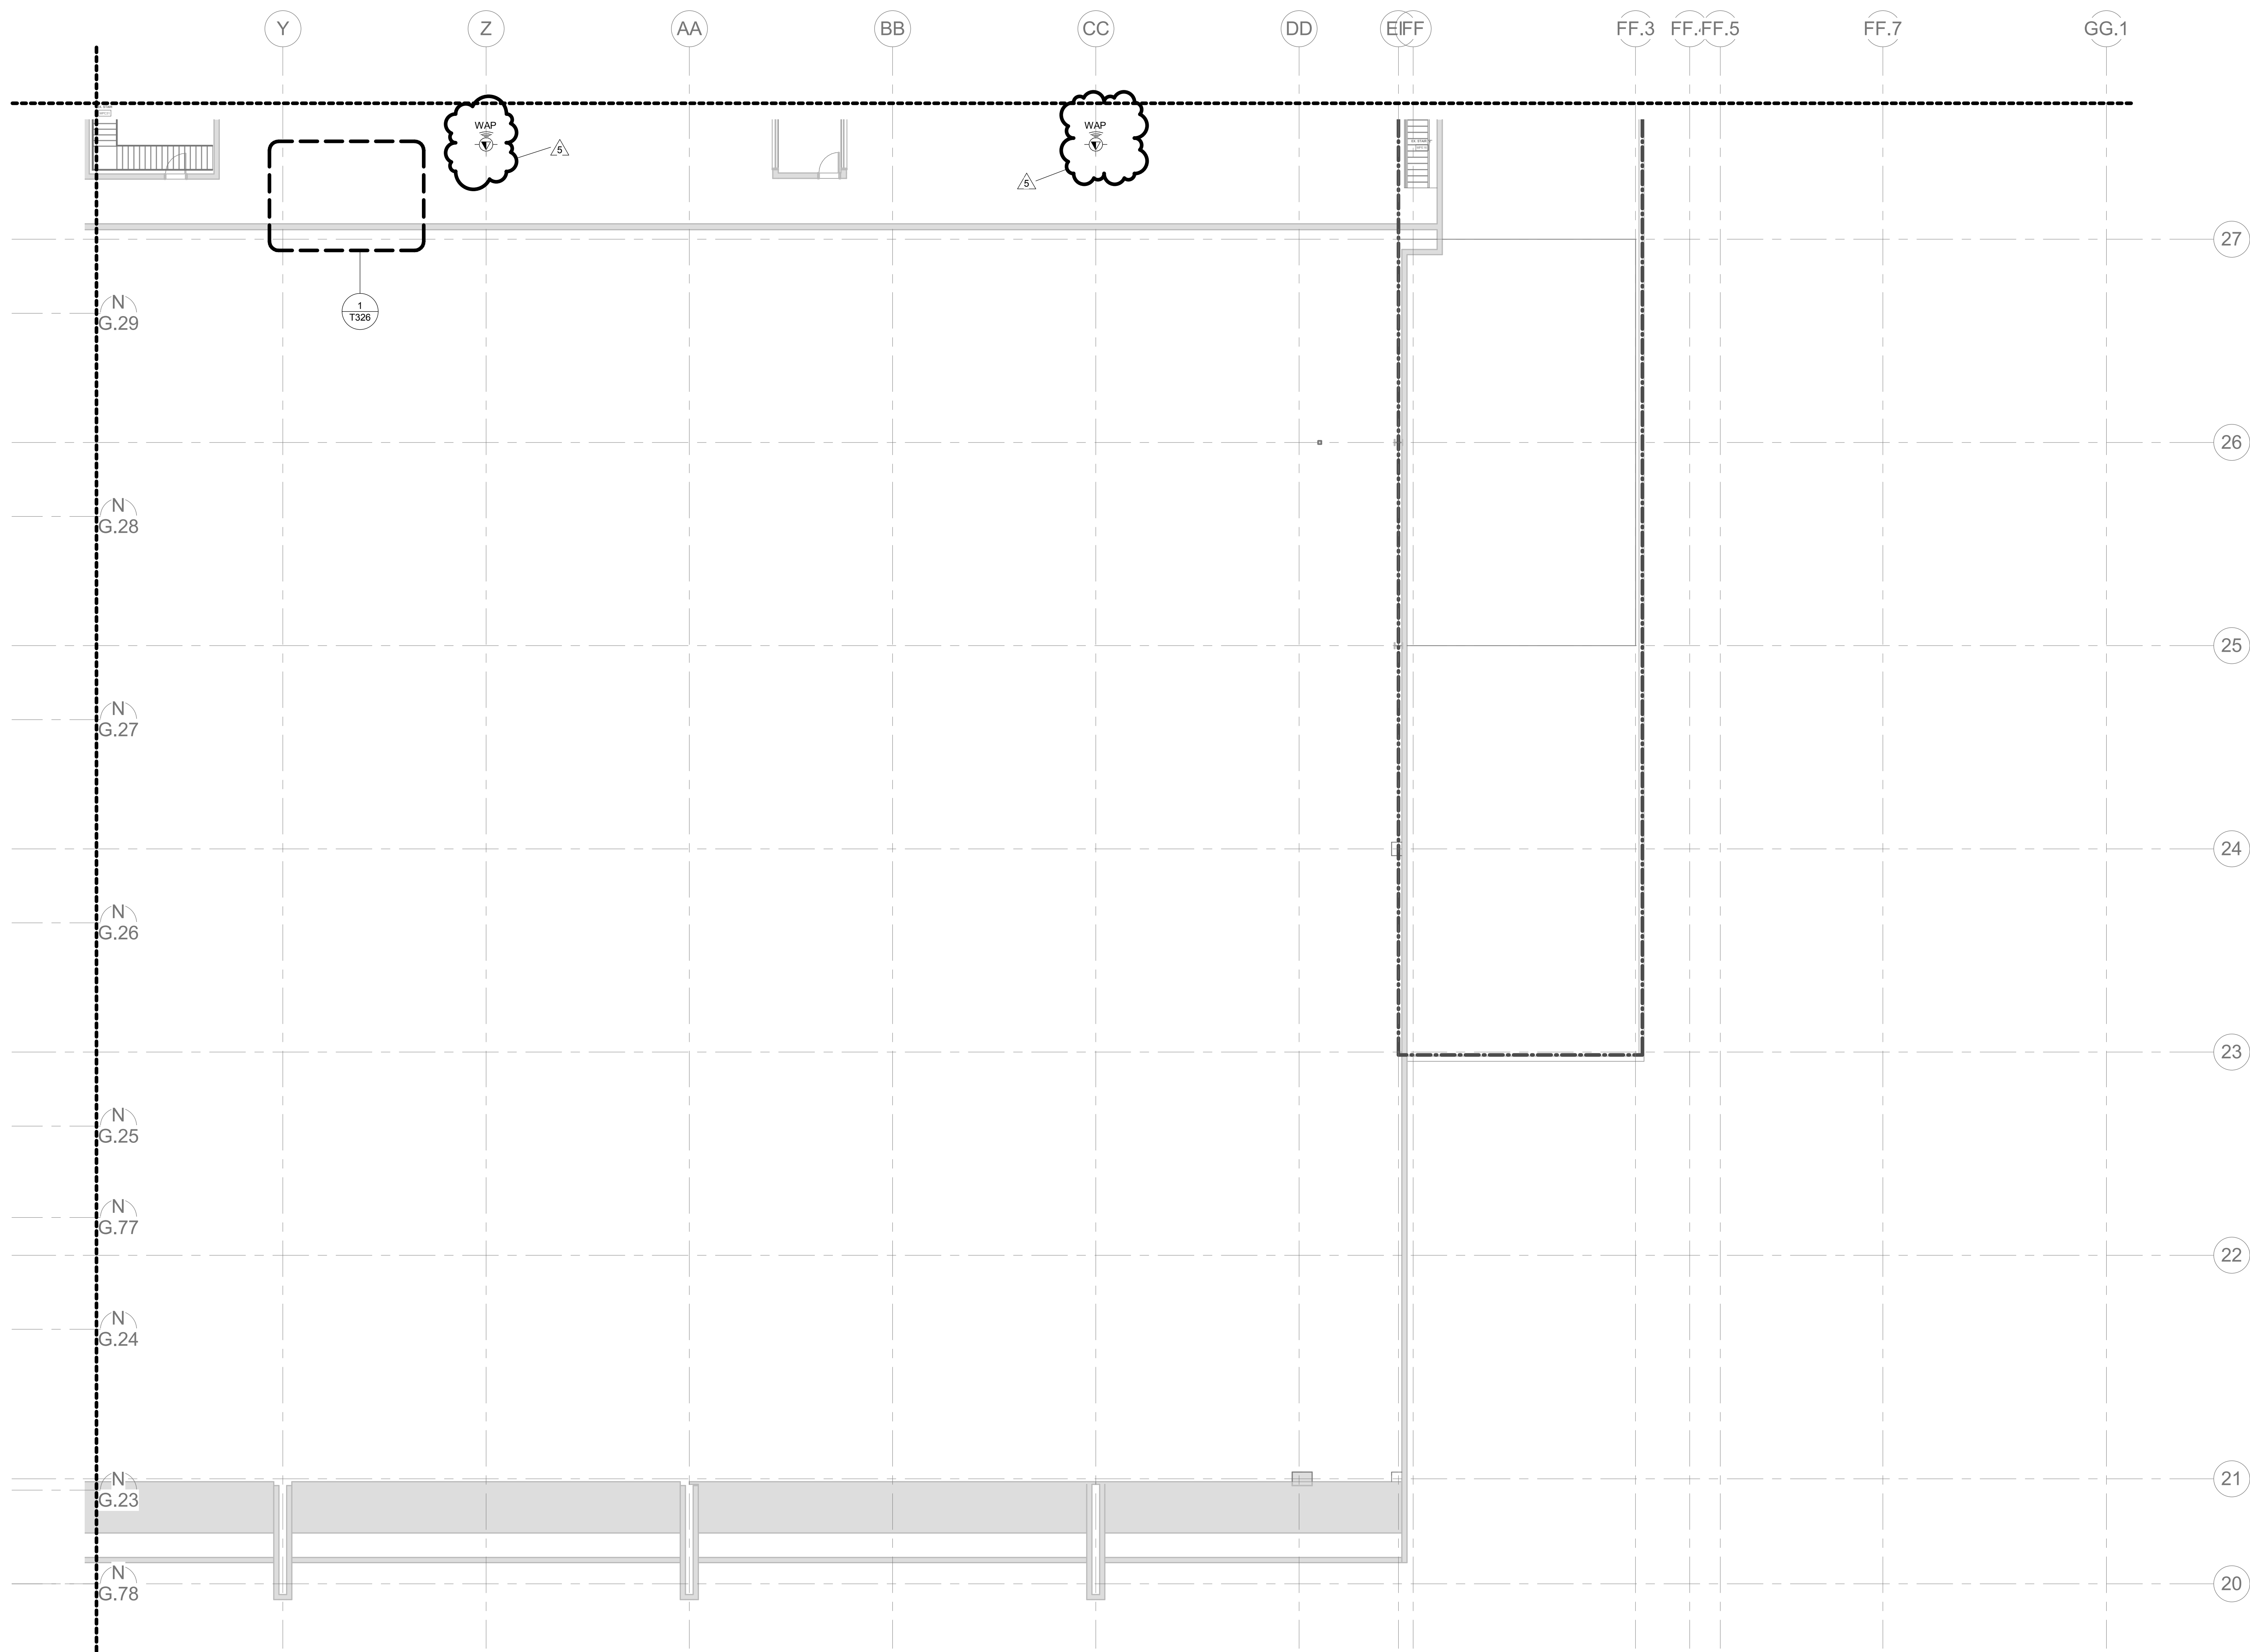




1 TELECOM MECHANICAL PENTHOUSE - AREA SE
3/32" = 1'-0"

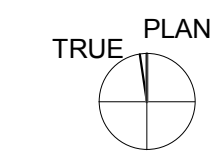KEYPLAN



NW	NC	NE
SW	SC	SE


DRAWING INFORMATION		KENTUCKY INTERNATIONAL CONVENTION CENTER RENOVATION AND EXPANSION			
A&E FILE NO.	14.03019.00	TELECOM MECHANICAL PENTHOUSE - AREA SE		DRAWING NO.	
DRAWING DATE	09/19/16	ACCOUNT NO. 235 C77K		T140F	
DRAWN BY	RZ	COMMONWEALTH OF KENTUCKY FINANCE AND ADMINISTRATION CABINET DEPARTMENT FOR FACILITIES & SUPPORT SERVICES DIVISION OF ENGINEERING AND CONTRACT ADMINISTRATION FRANKFORT, KENTUCKY		AS BUILT DATE	
CHECKED BY	JF			DECA LOG #	
PHASE	D				
RTA DATE		REVISION HISTORY OF THIS DRAWING			
		DESCRIPTION OF REVISIONS	DATE	DESCRIPTION OF REVISIONS	DATE
		100 CONSOLIDATED CONSTRUCTION SET	05/22/17		
		101 PR#	9/20/2017		

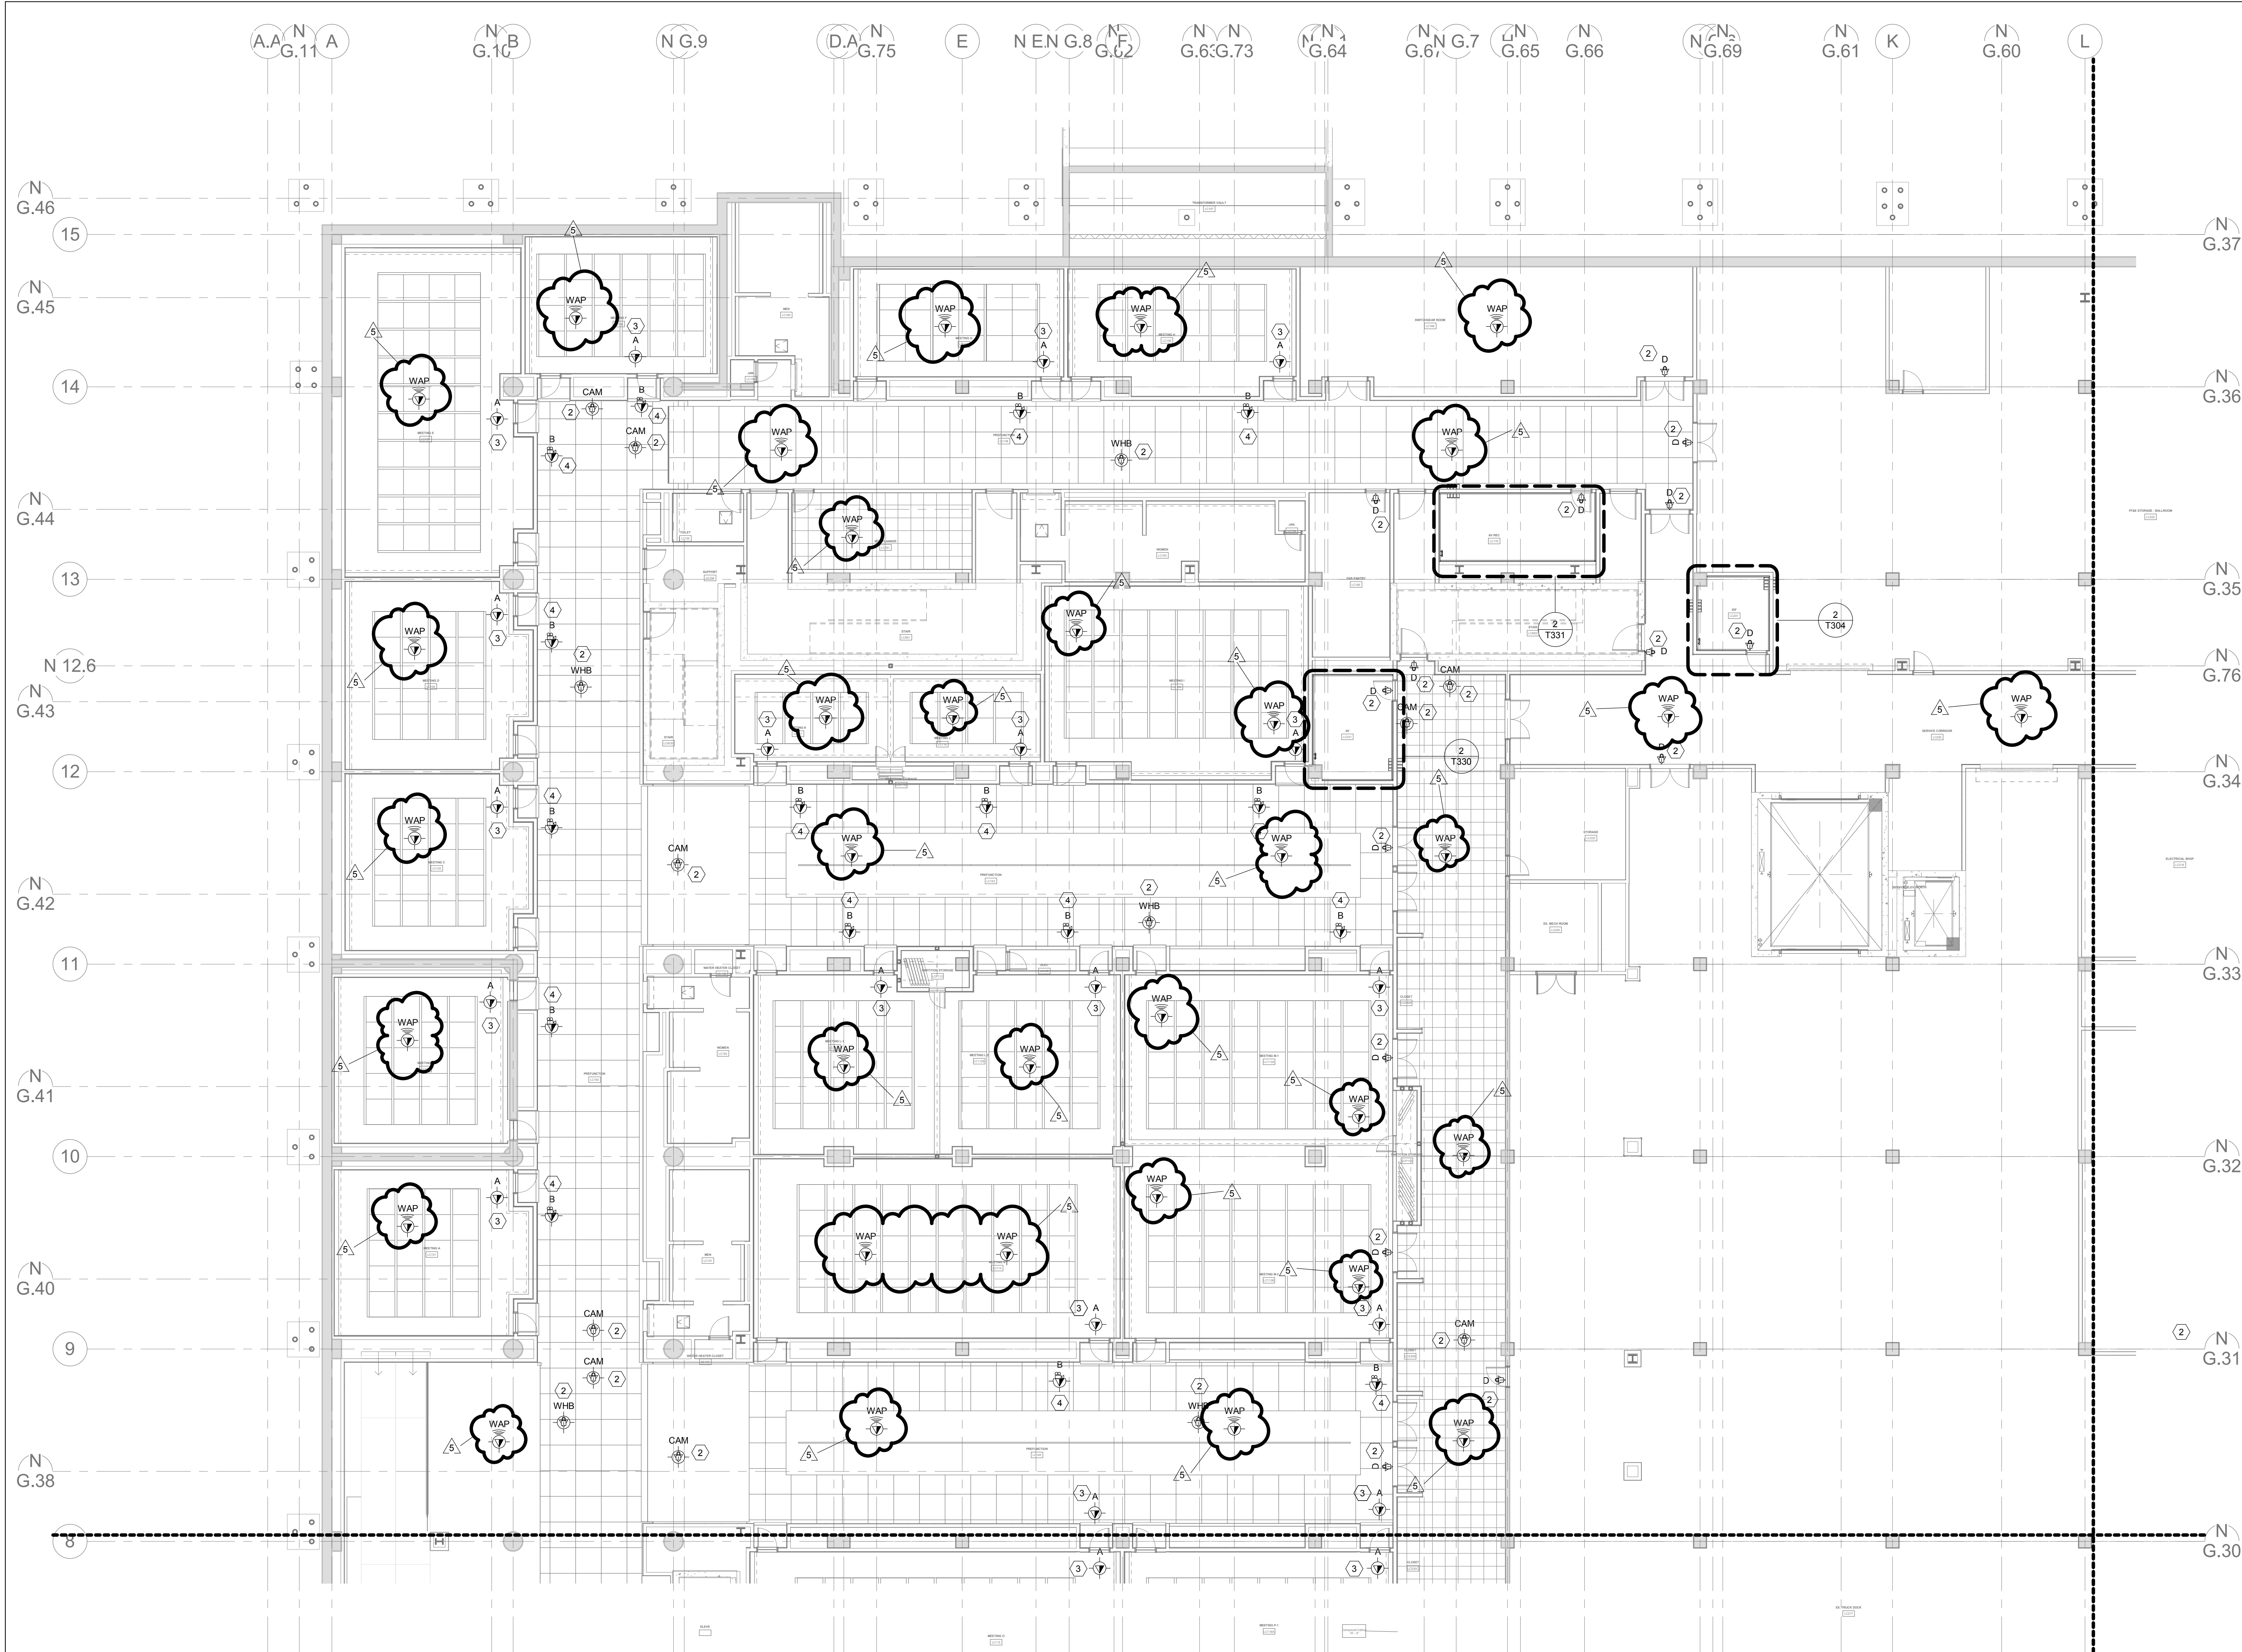



- SHEET NOTES** (#)
1. REFER TO AV DRAWINGS FOR ADDITIONAL INFORMATION.
 2. REFER TO SECURITY DRAWINGS FOR ADDITIONAL INFORMATION.
 3. COORDINATE CONNECTION TO IN CEILING LIGHTING CONTROL DEVICE WITH EC.
 4. CABLES ARE FOR FUTURE DIGITAL MEETING ROOM SCHEDULE DISPLAYS.

1 TELECOM LOWER CONCOURSE - AREA NW
3/32" = 1'-0"

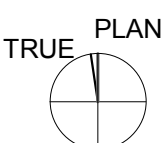KEYPLAN




NW	NC	NE
SW	SC	SE

DRAWING INFORMATION		KENTUCKY INTERNATIONAL CONVENTION CENTER RENOVATION AND EXPANSION			
A&E FILE NO.	14.03019.00	TELECOM LOWER CONCOURSE RCP - AREA NW		DRAWING NO.	
DRAWN BY	RZ	ACCOUNT NO.	COMMONWEALTH OF KENTUCKY FINANCE AND ADMINISTRATION CABINET DEPARTMENT FOR FACILITIES & SUPPORT SERVICES DIVISION OF ENGINEERING AND CONTRACT ADMINISTRATION FRANKFORT, KENTUCKY		
CHECKED BY	JF	235 C77K			
PHASE	D				
RTA DATE					
 SHEN MILSOOM WILKE		REVISION HISTORY OF THIS DRAWING			AS BUILT DATE
		DESCRIPTION OF REVISIONS			DATE
		100	CONSOLIDATED CONSTRUCTION SET	05/22/17	
		101	PR#	9/20/2017	
		DESCRIPTION OF REVISIONS			DATE




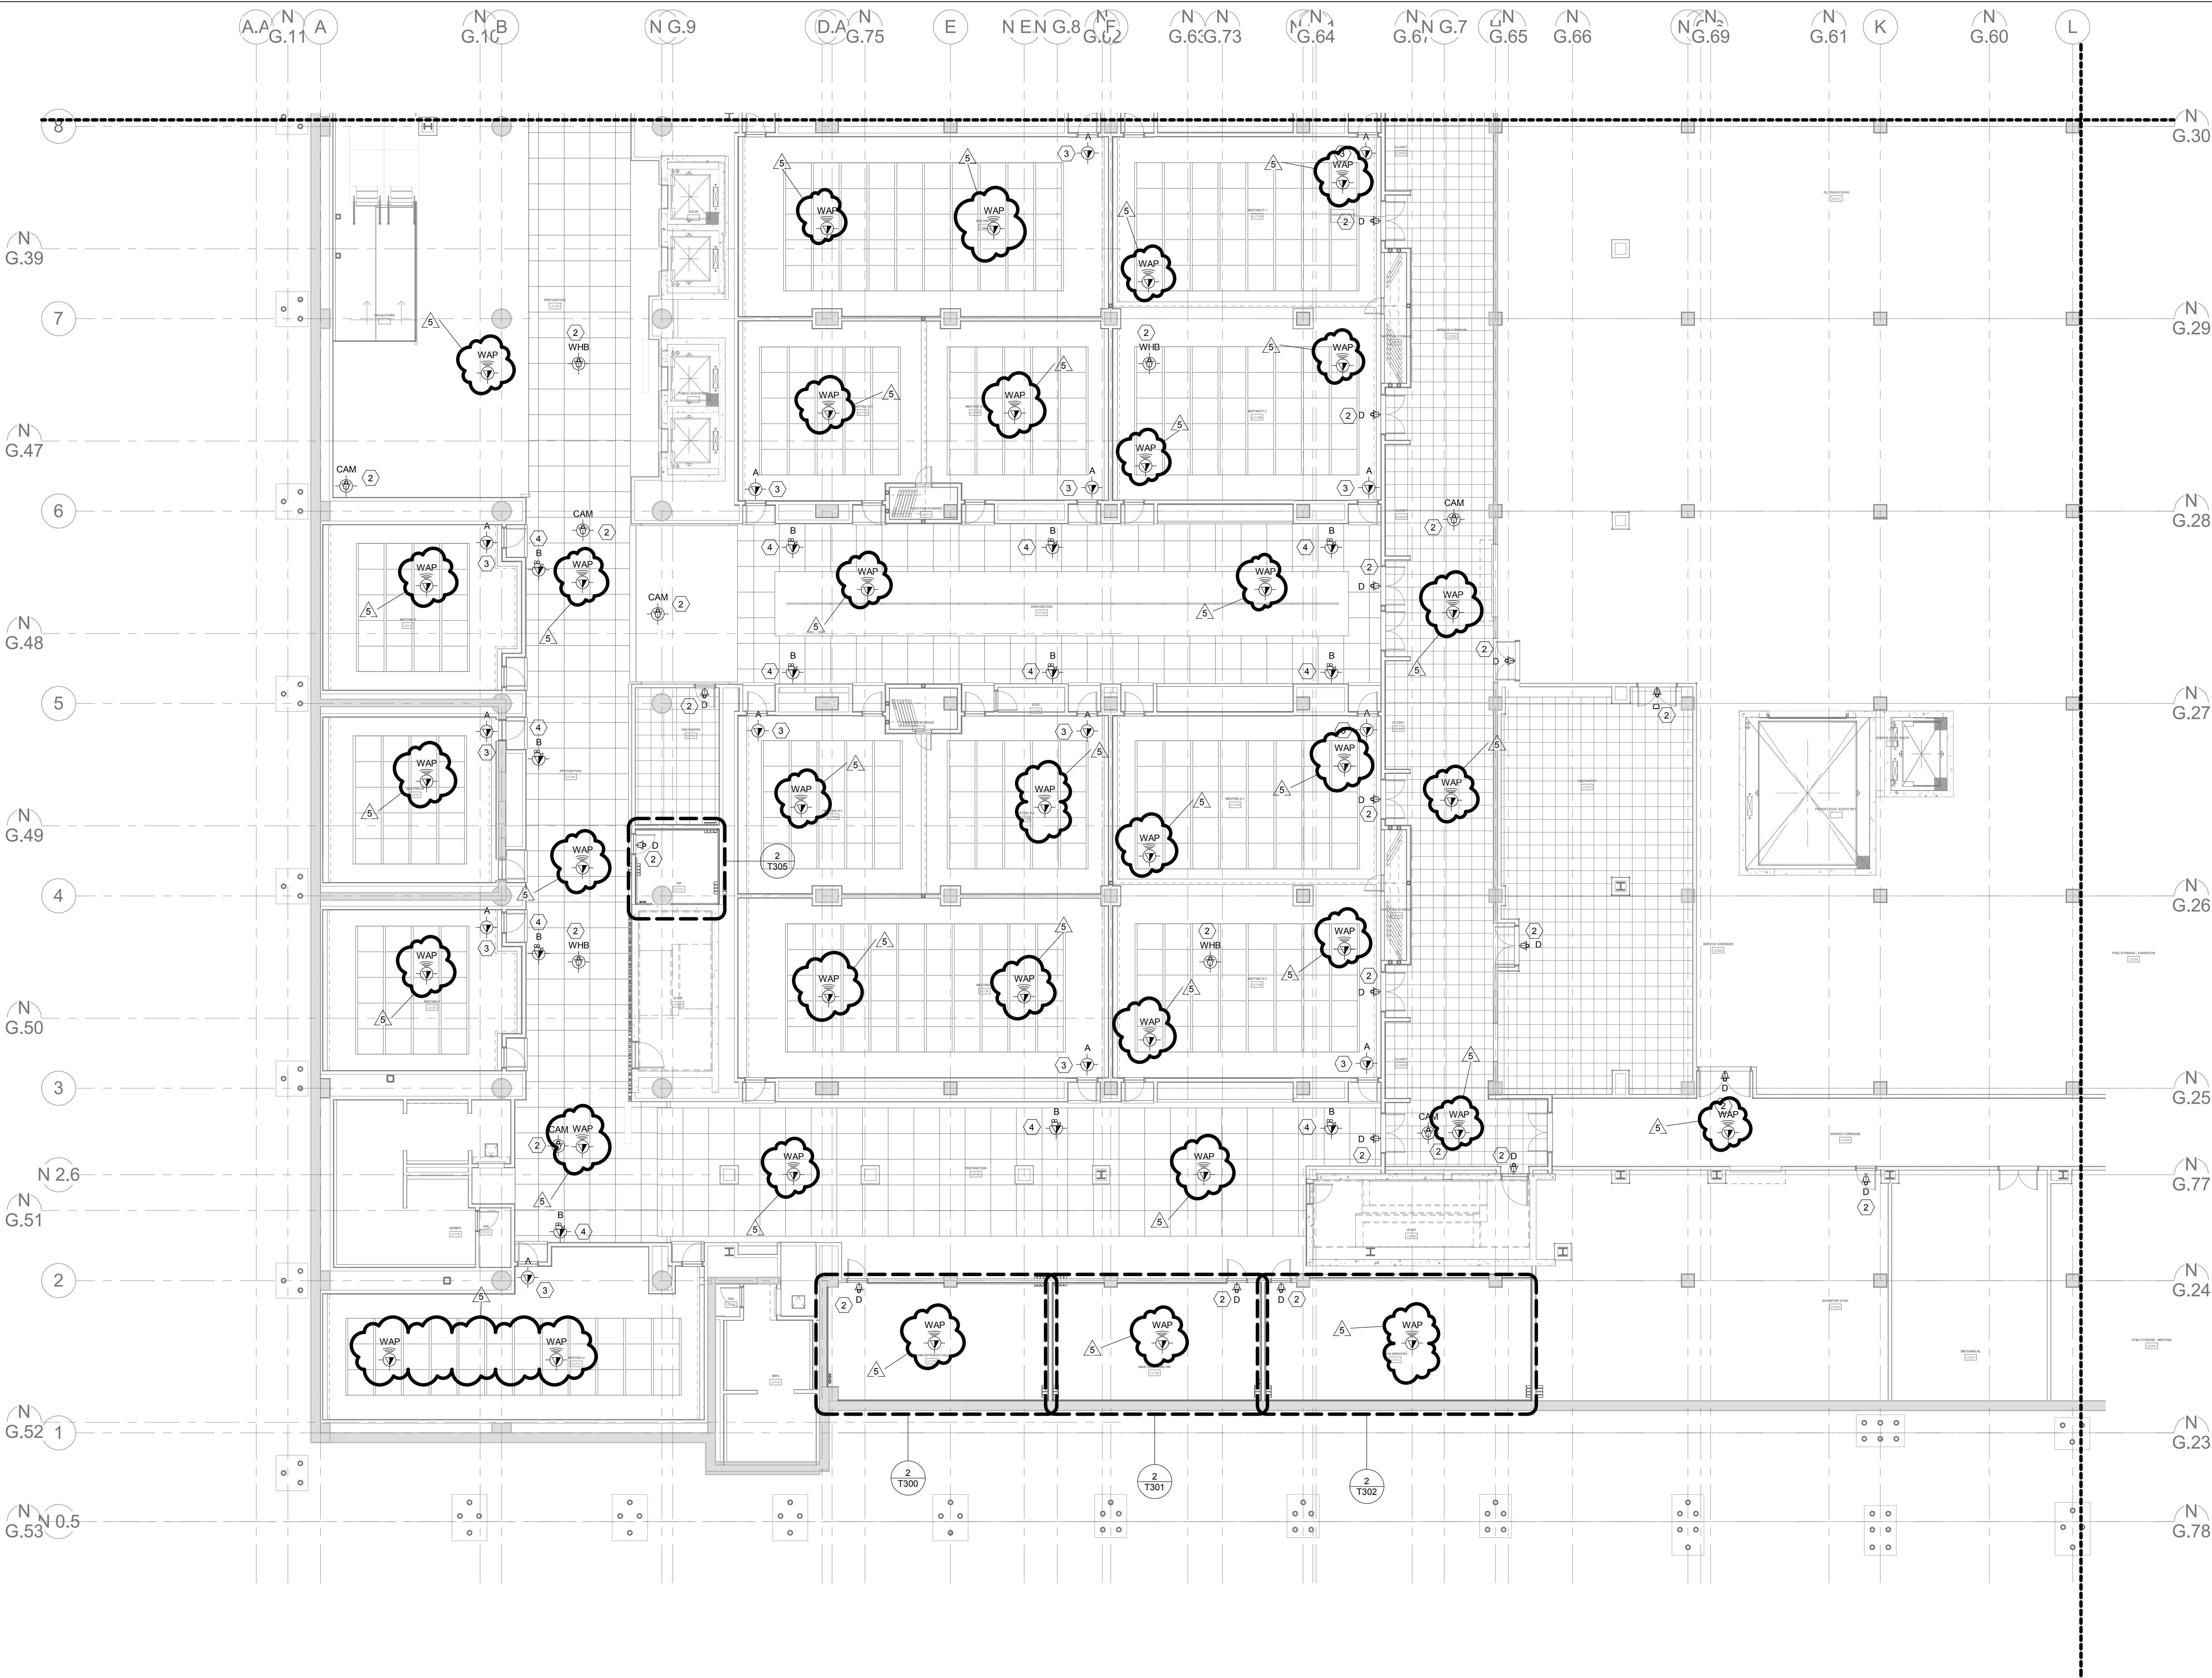

DRAWING NO.
T200A
AS BUILT DATE
DECA LOG #




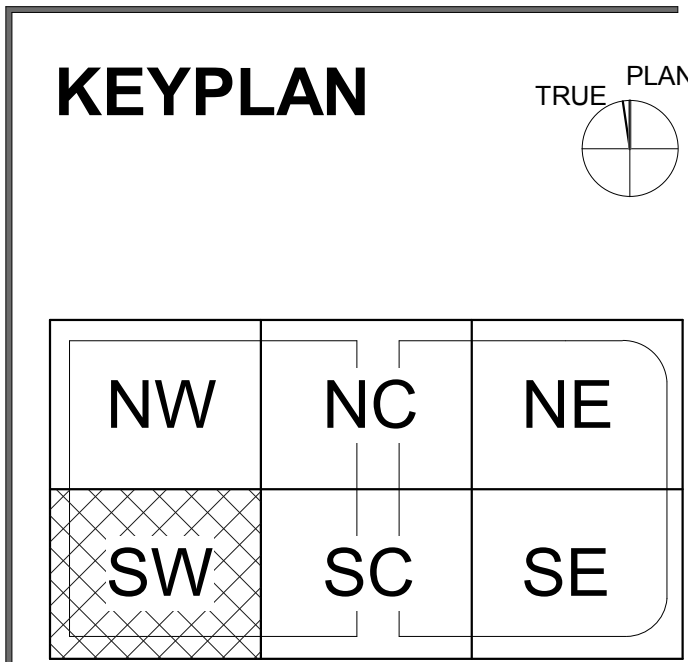

- SHEET NOTES**
1. REFER TO AV DRAWINGS FOR ADDITIONAL INFORMATION.
 2. REFER TO SECURITY DRAWINGS FOR ADDITIONAL INFORMATION.
 3. COORDINATE CONNECTION TO IN CEILING LIGHTING CONTROL DEVICE WITH EC.
 4. CABLES ARE FOR FUTURE DIGITAL MEETING ROOM SCHEDULE DISPLAYS.


1 TELECOM LOWER CONCOURSE - AREA SW
3/32" = 1'-0"

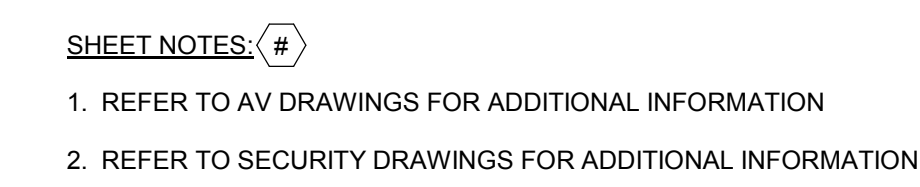

DRAWING INFORMATION		KENTUCKY INTERNATIONAL CONVENTION CENTER RENOVATION AND EXPANSION			
A&E FILE NO.	14.03019.00	TELECOM LOWER CONCOURSE RCP - AREA SW		DRAWING NO.	
DRAWING DATE	09/19/16			T200B	
DRAWN BY	RZ	ACCOUNT NO.	COMMONWEALTH OF KENTUCKY FINANCE AND ADMINISTRATION CABINET DEPARTMENT FOR FACILITIES & SUPPORT SERVICES DIVISION OF ENGINEERING AND CONTRACT ADMINISTRATION FRANKFORT, KENTUCKY		
CHECKED BY	JF	235 C77K			
PHASE	D				
RTA DATE					AS BUILT DATE
 SHEN MILSON WILKE		 architecture interiors			DECA LOG #
		REVISION HISTORY OF THIS DRAWING			
		DESCRIPTION OF REVISIONS	DATE	DESCRIPTION OF REVISIONS	DATE
100		CONSOLIDATED CONSTRUCTION SET	05/22/17		
101		PR#	9/20/2017		




DRAWING INFORMATION		KENTUCKY INTERNATIONAL CONVENTION CENTER RENOVATION AND EXPANSION				DRAWING NO.																									
A&E FILE NO.	14-0319.00.00	TELECOM LOWER CONCOURSE RCP - AREA NC				T200C																									
DRAWING DATE	08/19/16																														
DRAWN BY	RZ	ACCOUNT NO.	235 C77K	COMMONWEALTH OF KENTUCKY FINANCE AND ADMINISTRATION CABINET DEPARTMENT FOR FACILITIES & SUPPORT SERVICES DIVISION OF ENGINEERING AND CONTRACT ADMINISTRATION FRANKFORT, KENTUCKY		AS-BUILT DATE DECA LOG #																									
CHECKED BY	JF																														
PHASE	D																														
RTA DATE																															
		<table border="1"> <thead> <tr> <th colspan="2">DESCRIPTION OF REVISIONS</th> <th colspan="2">DATE</th> <th colspan="2">DESCRIPTION OF REVISIONS</th> <th colspan="2">DATE</th> </tr> </thead> <tbody> <tr> <td>100</td> <td>CONSOLIDATED CONSTRUCTION SET</td> <td>05/22/17</td> <td></td> <td></td> <td></td> <td></td> <td></td> </tr> <tr> <td>101</td> <td>PR#</td> <td>9/20/2017</td> <td></td> <td></td> <td></td> <td></td> <td></td> </tr> </tbody> </table>						DESCRIPTION OF REVISIONS		DATE		DESCRIPTION OF REVISIONS		DATE		100	CONSOLIDATED CONSTRUCTION SET	05/22/17						101	PR#	9/20/2017					
DESCRIPTION OF REVISIONS		DATE		DESCRIPTION OF REVISIONS		DATE																									
100	CONSOLIDATED CONSTRUCTION SET	05/22/17																													
101	PR#	9/20/2017																													

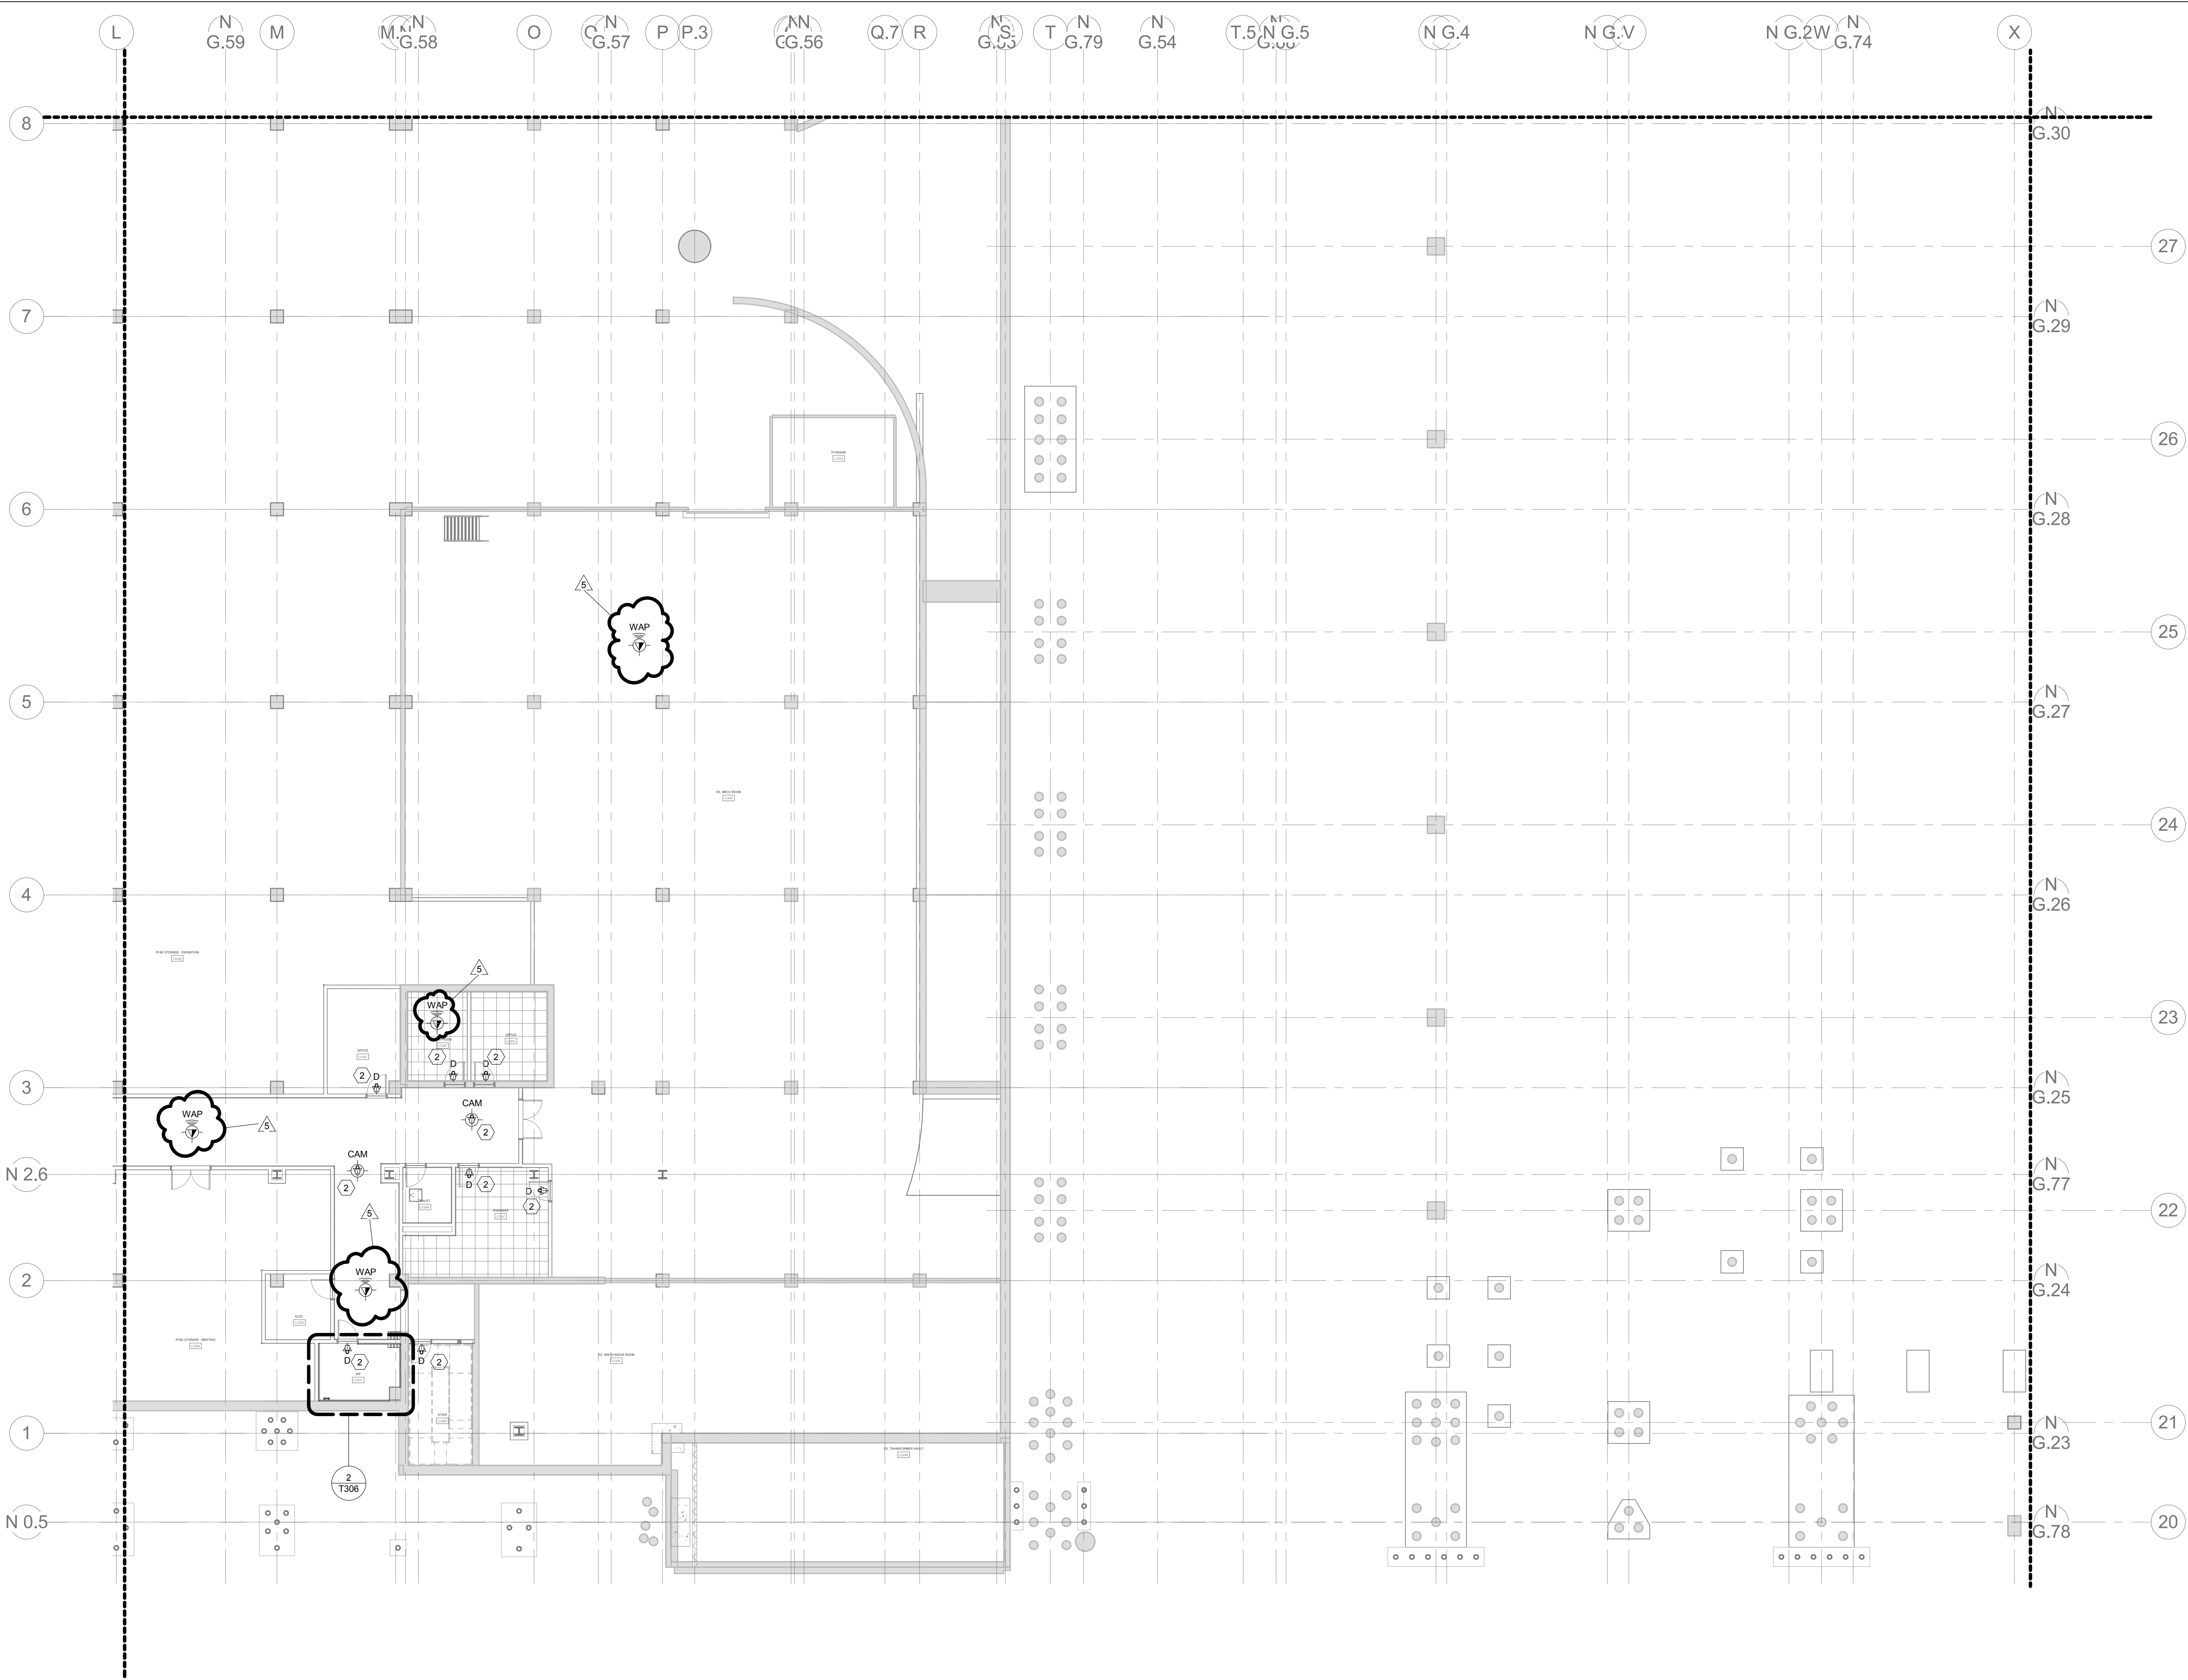

- SHEET NOTES: (#)
1. REFER TO AV DRAWINGS FOR ADDITIONAL INFORMATION
 2. REFER TO SECURITY DRAWINGS FOR ADDITIONAL INFORMATION.

1 TELECOM LOWER CONCOURSE - AREA SC
3/32" = 1'-0"

KEYPLAN

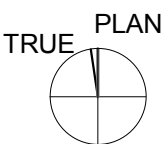

NW	NC	NE
SW	SC	SE

DRAWING INFORMATION	
A&E FILE NO.	14.03019.00
DRAWING DATE	09/19/16
DRAWN BY	RZ
CHECKED BY	JF
PHASE	D
RTA DATE	



KENTUCKY INTERNATIONAL CONVENTION CENTER
RENOVATION AND EXPANSION

TELECOM LOWER CONCOURSE RCP - AREA SC

ACCOUNT NO.
235 C77K

COMMONWEALTH OF KENTUCKY
FINANCE AND ADMINISTRATION CABINET
DEPARTMENT FOR FACILITIES & SUPPORT SERVICES
DIVISION OF ENGINEERING AND CONTRACT ADMINISTRATION
FRANKFORT, KENTUCKY




DESCRIPTION OF REVISIONS	DATE	DESCRIPTION OF REVISIONS	DATE
100 CONSOLIDATED CONSTRUCTION SET	05/22/17		
101 PR#	9/20/2017		

DRAWING NO.

T200D

AS BUILT DATE


DECA LOG #

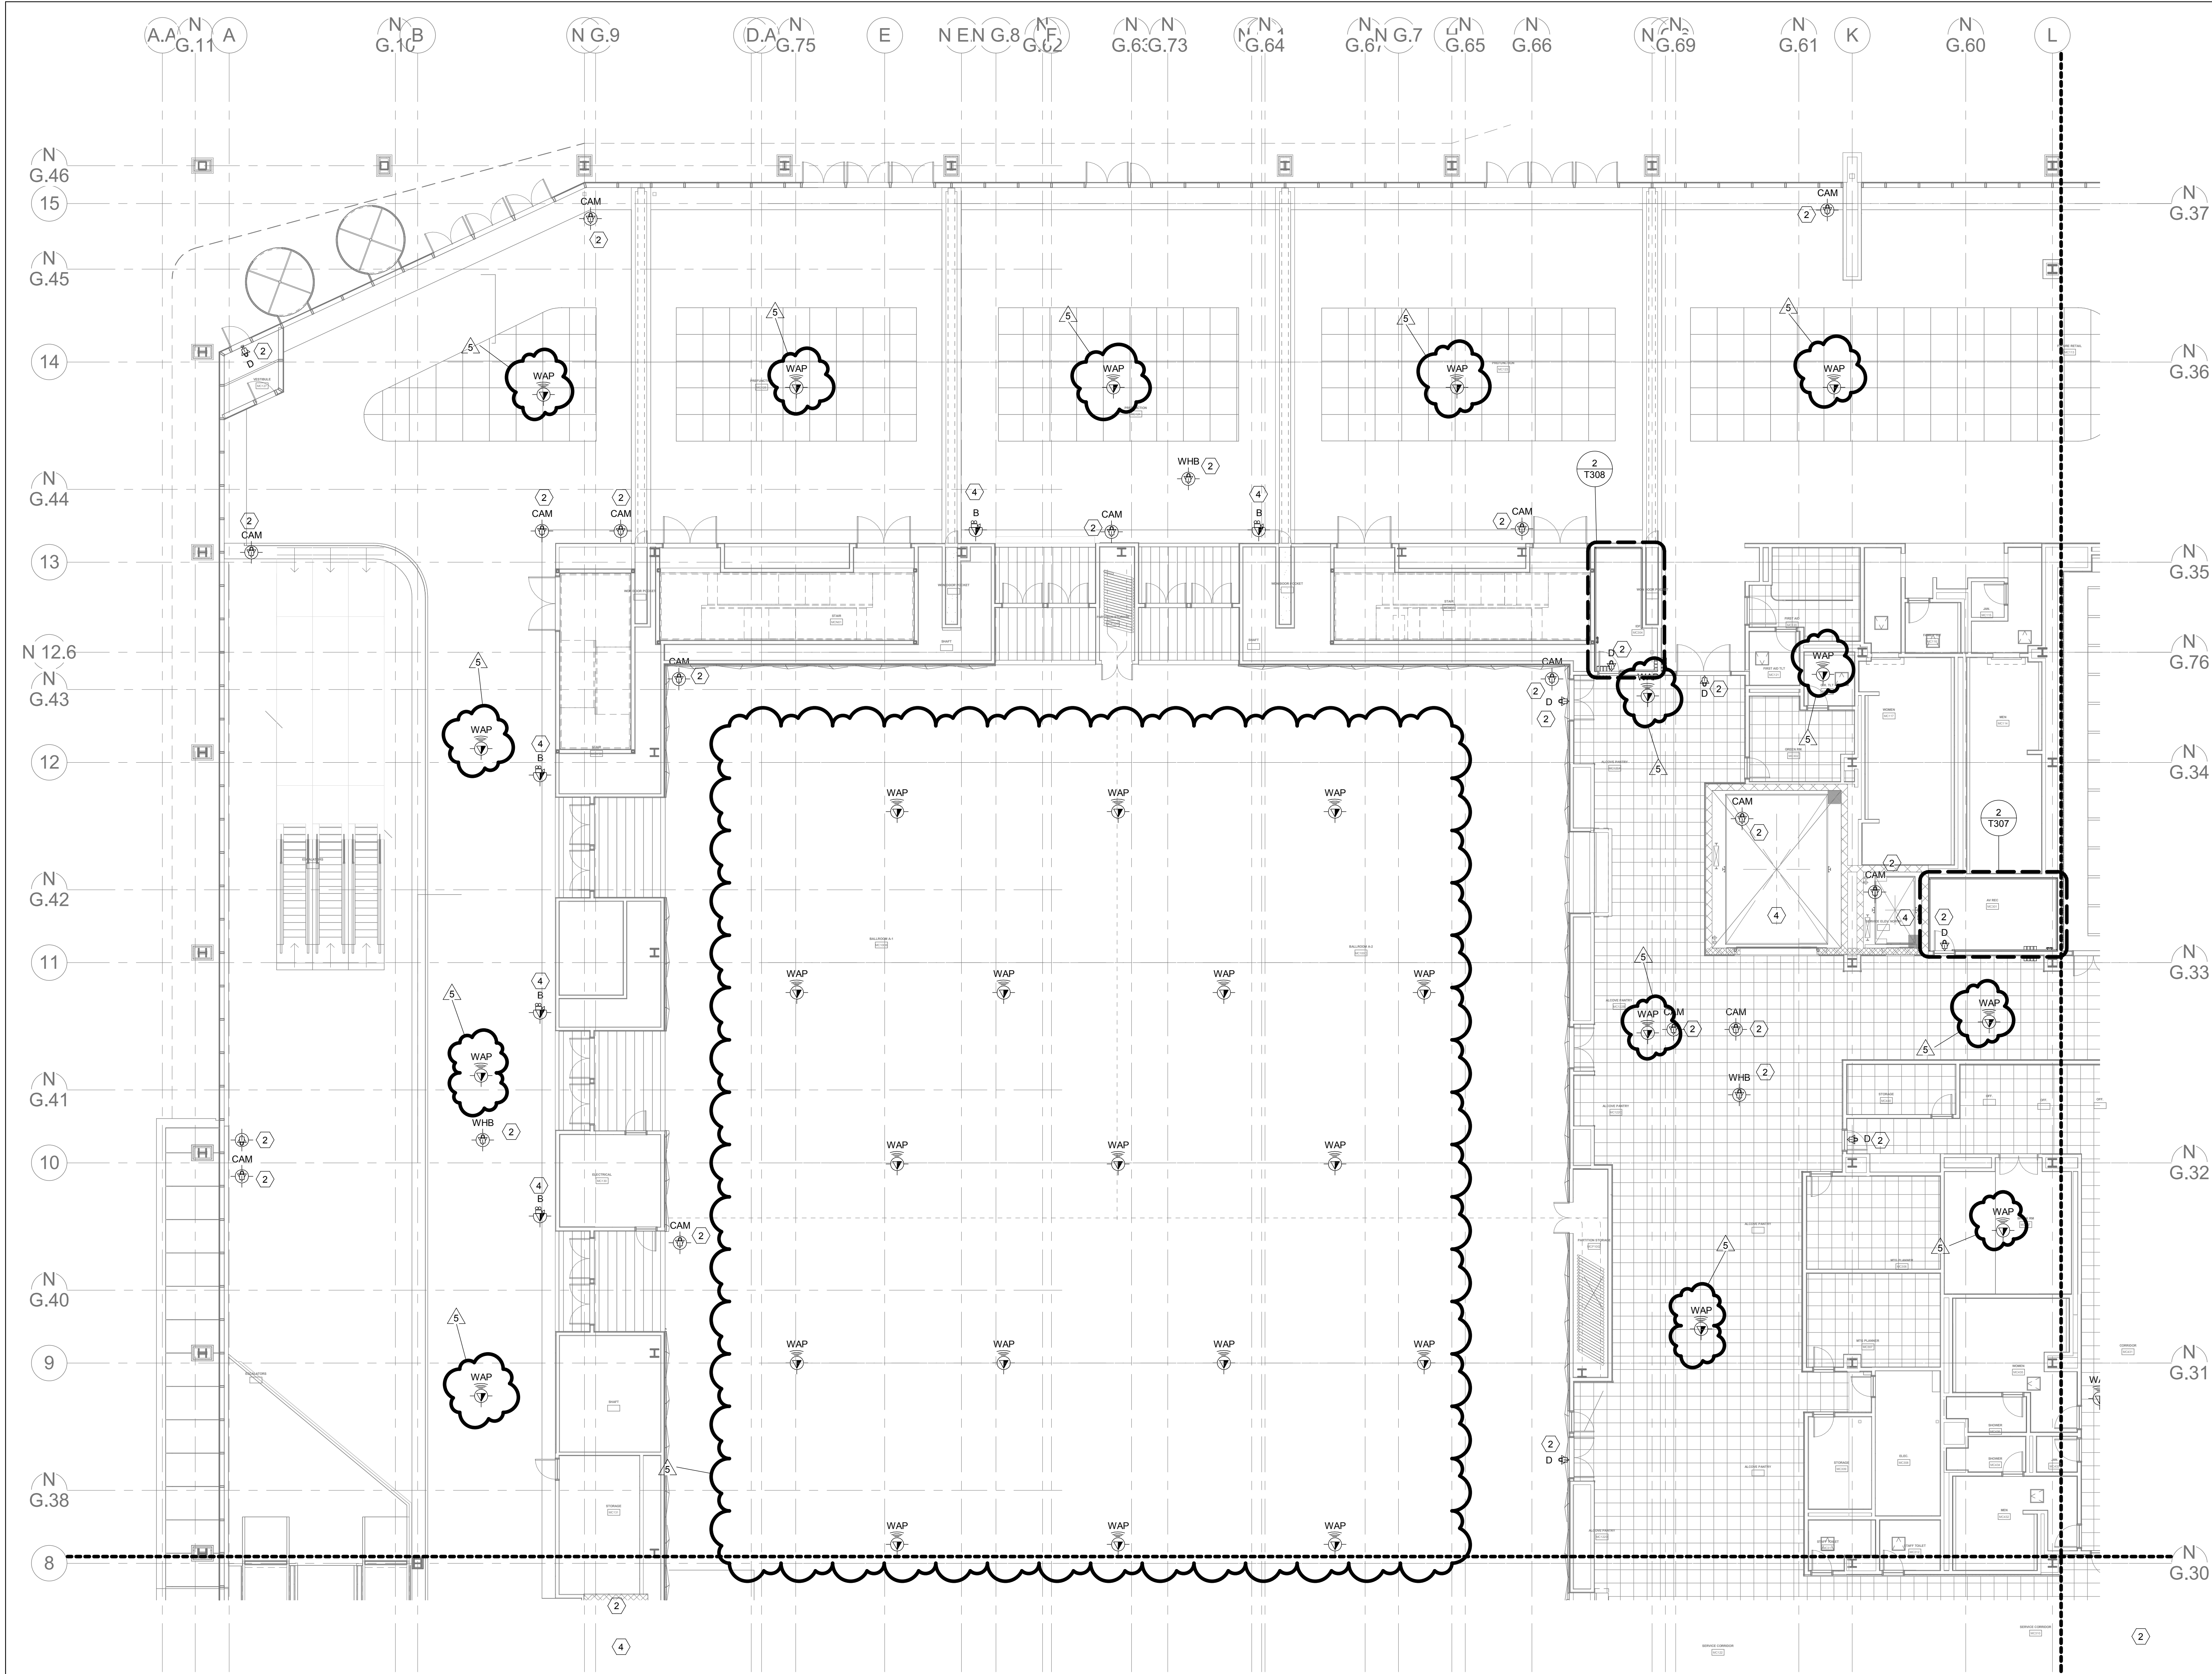




- SHEET NOTES:**
1. REFER TO AV DRAWINGS FOR ADDITIONAL INFORMATION.
 2. REFER TO SECURITY DRAWINGS FOR ADDITIONAL INFORMATION.
 3. CABLES ARE FOR FUTURE DIGITAL MEETING ROOM SCHEDULE DISPLAYS.
 4. INSTALL ELEVATOR CABLING TO THE CORRESPONDING ELEVATOR MACHINE ROOM.

1 TELECOM MAIN CONCOURSE - AREA NW
3/32" = 1'-0"

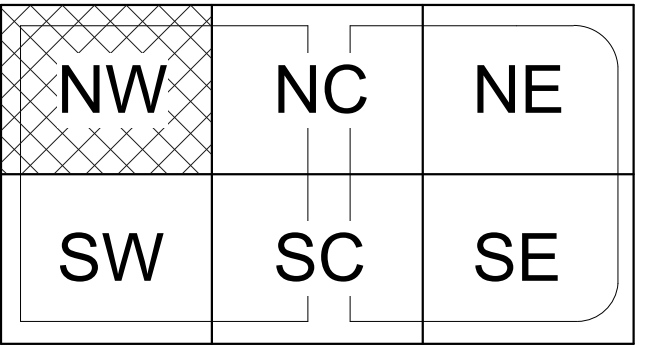KEYPLAN





DRAWING INFORMATION		KENTUCKY INTERNATIONAL CONVENTION CENTER RENOVATION AND EXPANSION				DRAWING NO. T210A
A&E FILE NO.	14.03019.00	TELECOM MAIN CONCOURSE RCP - AREA NW				
DRAWING DATE	09/19/16	ACCOUNT NO. 235 C77K COMMONWEALTH OF KENTUCKY FINANCE AND ADMINISTRATION CABINET DEPARTMENT FOR FACILITIES & SUPPORT SERVICES DIVISION OF ENGINEERING AND CONTRACT ADMINISTRATION FRANKFORT, KENTUCKY				AS BUILT DATE
DRAWN BY	RZ					
CHECKED BY	JF	 architecture interiors				DECA LOG #
PHASE	D					
RTA DATE						
 SHEN MILSON WILKE		REVISION HISTORY OF THIS DRAWING				
		DESCRIPTION OF REVISIONS		DATE	DESCRIPTION OF REVISIONS	DATE
		100	CONSOLIDATED CONSTRUCTION SET	05/22/17		
		101	PR#	9/20/2017		

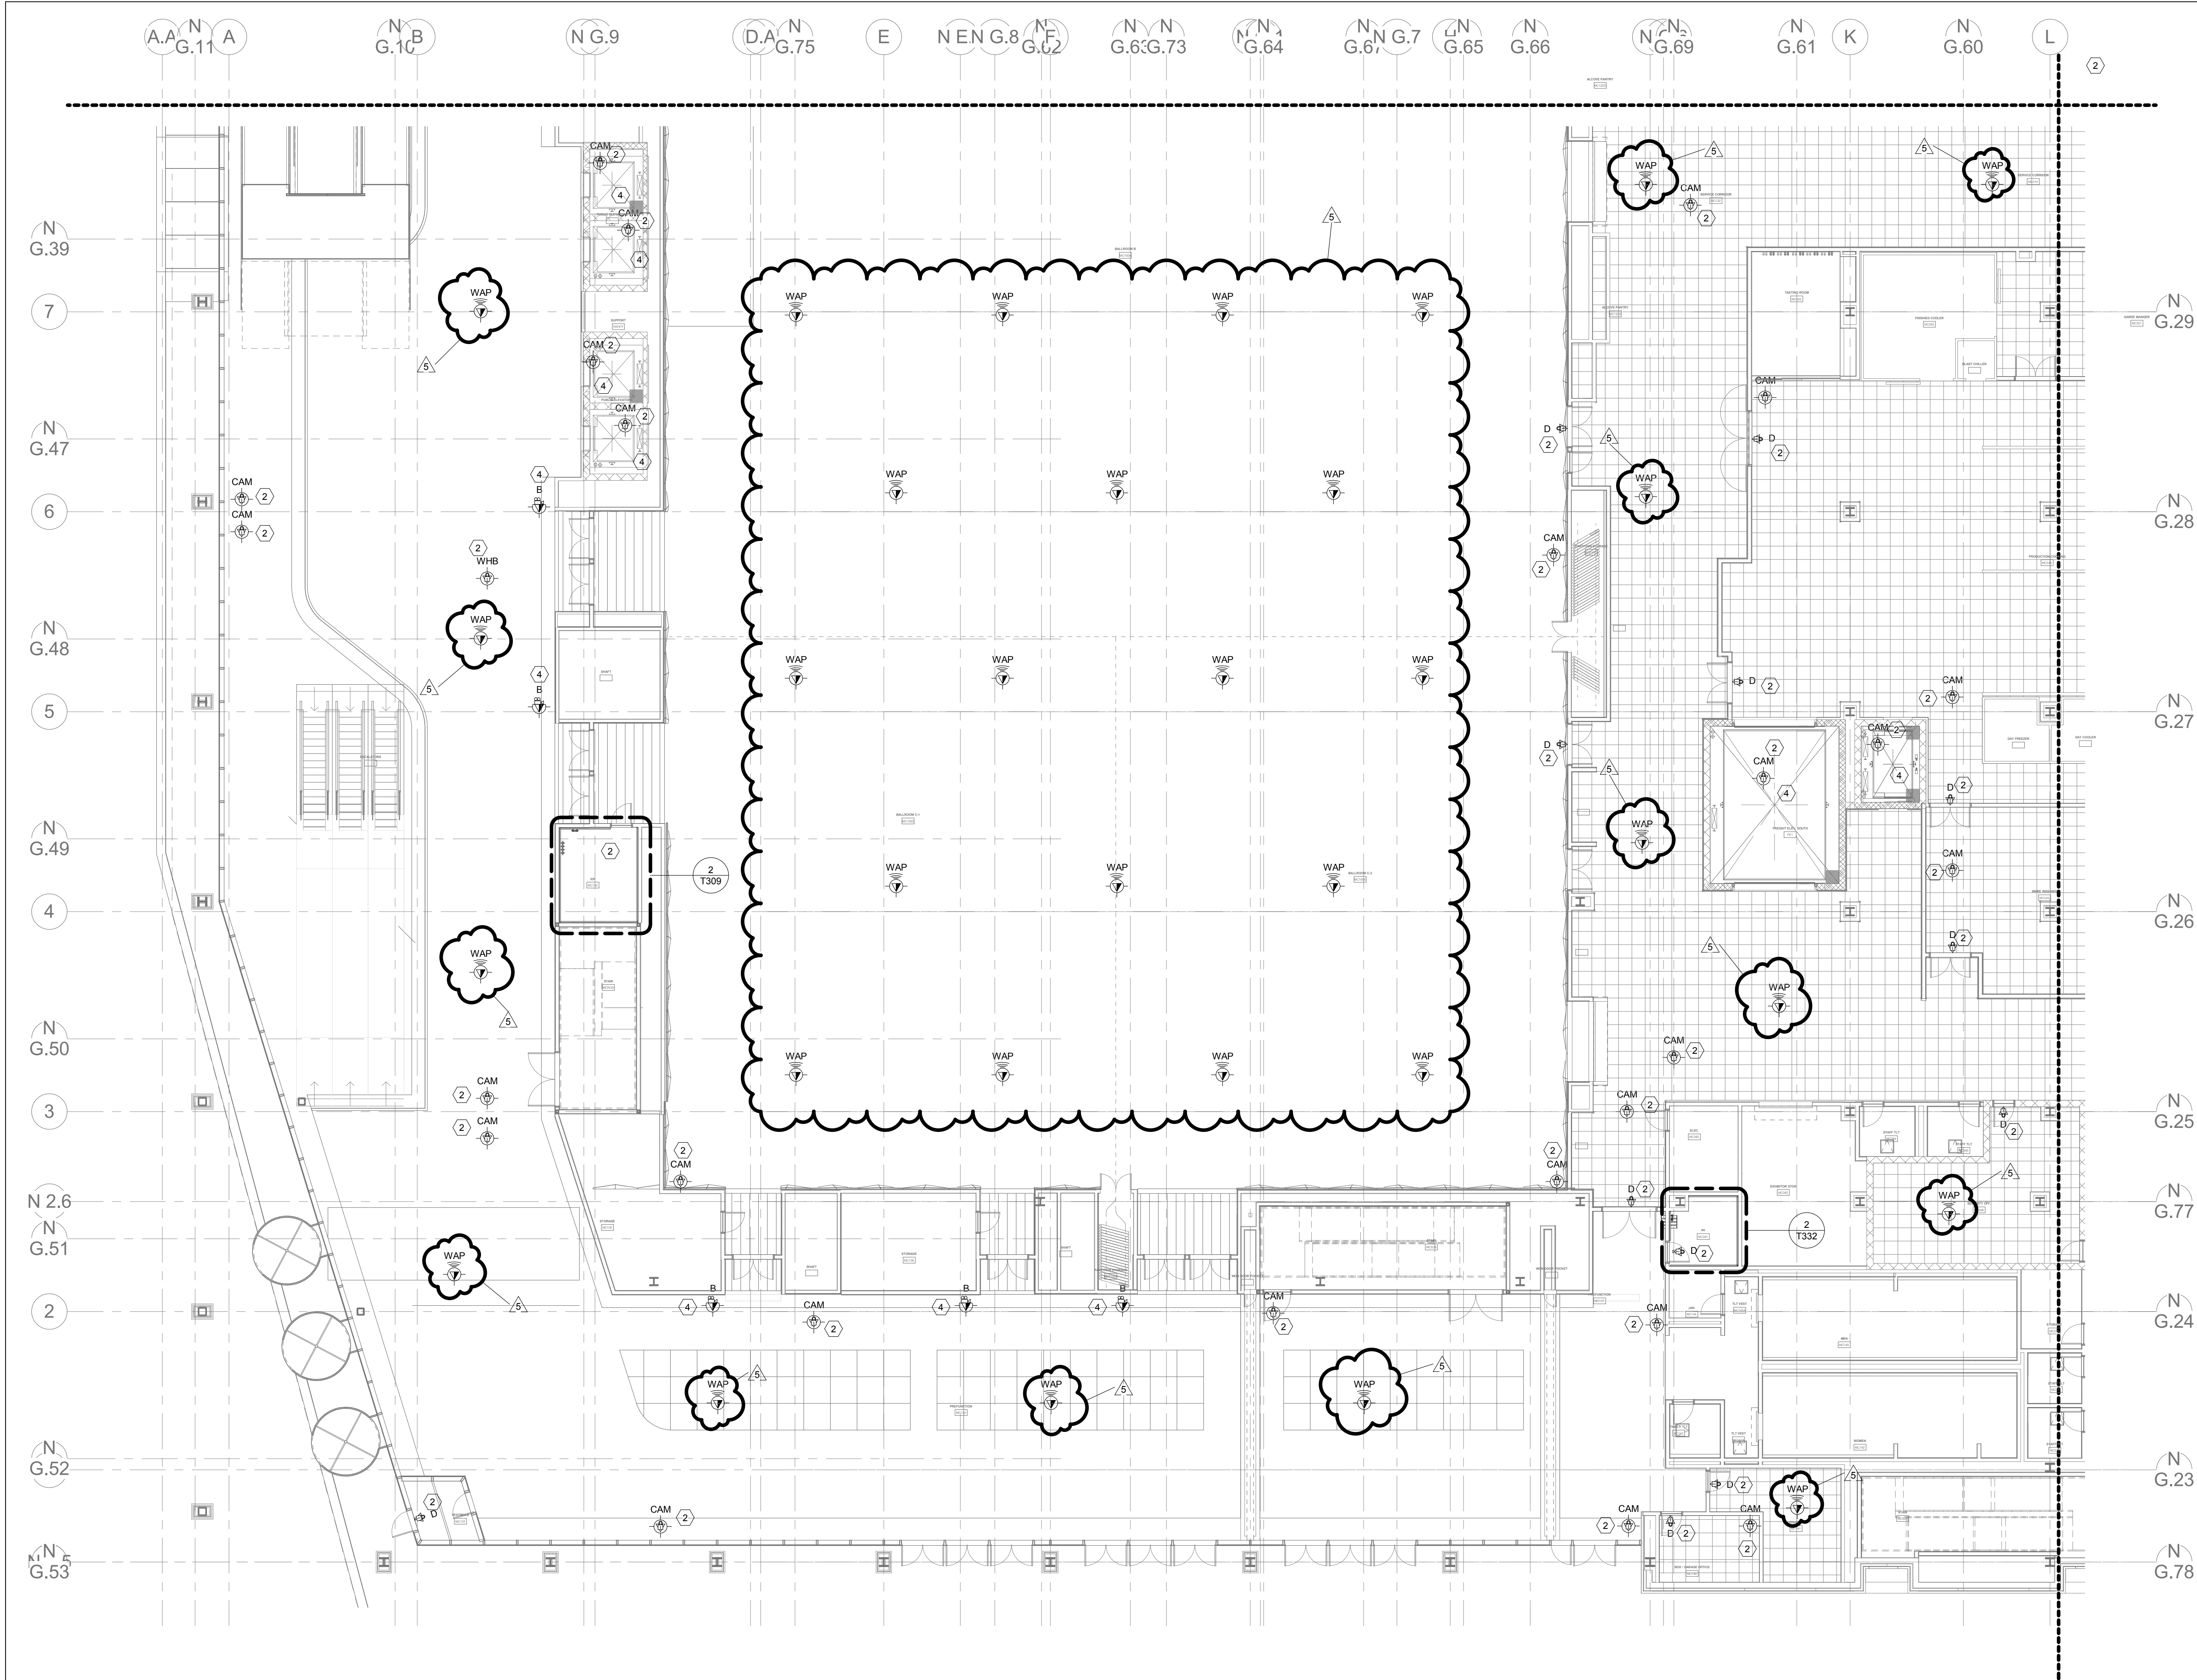

- SHEET NOTES**
1. REFER TO AV DRAWINGS FOR ADDITIONAL INFORMATION
 2. REFER TO SECURITY DRAWINGS FOR ADDITIONAL INFORMATION.
 3. CABLES ARE FOR FUTURE DIGITAL MEETING ROOM SCHEDULE DISPLAYS.
 4. INSTALL ELEVATOR CABLING TO THE CORRESPONDING ELEVATOR MACHINE ROOM

1 TELECOM MAIN CONCOURSE - AREA SW
3/32" = 1'-0"

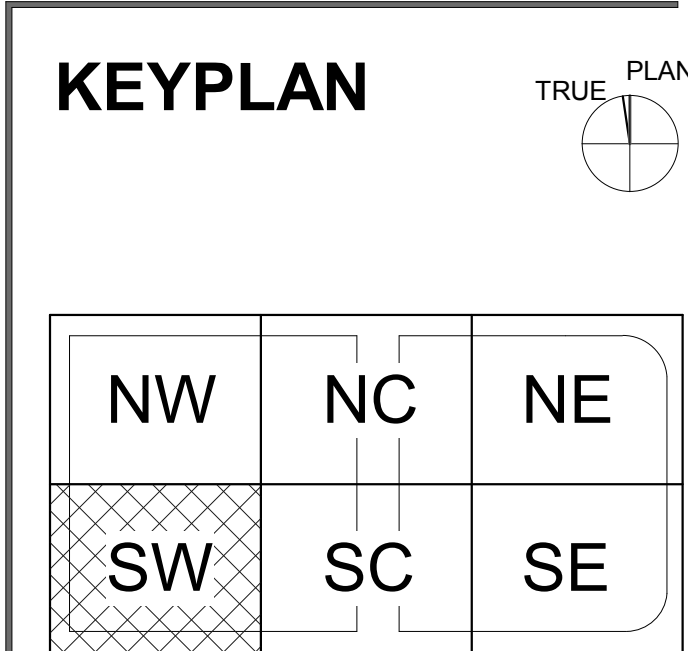


DRAWING INFORMATION		KENTUCKY INTERNATIONAL CONVENTION CENTER RENOVATION AND EXPANSION			
A&E FILE NO.	14.03019.00	TELECOM MAIN CONCOURSE RCP - AREA SW			DRAWING NO.
DRAWING DATE	09/19/16	 architecture interiors			T210B
DRAWN BY	RZ				
CHECKED BY	JF				COMMONWEALTH OF KENTUCKY FINANCE AND ADMINISTRATION CABINET DEPARTMENT FOR FACILITIES & SUPPORT SERVICES DIVISION OF ENGINEERING AND CONTRACT ADMINISTRATION FRANKFORT, KENTUCKY
PHASE	D				
RTA DATE					AS BUILT DATE
 SM&W SHEN MILSON WILKE		 architecture interiors			DECA LOG #
DESCRIPTION OF REVISIONS		DATE	DESCRIPTION OF REVISIONS	DATE	
100	CONSOLIDATED CONSTRUCTION SET	05/22/17			
101	PR#	9/20/2017			




- SHEET NOTES: (1)
1. REFER TO AV DRAWINGS FOR ADDITIONAL INFORMATION
 2. REFER TO SECURITY DRAWINGS FOR ADDITIONAL INFORMATION.
 3. CABLES ARE FOR FUTURE DIGITAL MEETING ROOM SCHEDULE DISPLAYS.
 4. INSTALL ELEVATOR CABLING TO THE CORRESPONDING ELEVATOR MACHINE ROOM

1 TELECOM MAIN CONCOURSE - AREA NC
3/32" = 1'-0"

KEYPLAN

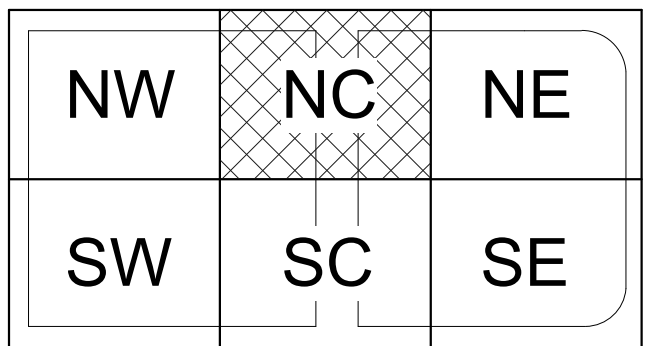



DRAWING INFORMATION		KENTUCKY INTERNATIONAL CONVENTION CENTER RENOVATION AND EXPANSION	
A&E FILE NO.	14.03019.00	DRAWING NO.	
DRAWING DATE	09/19/16	TELECOM MAIN CONCOURSE RCP - AREA NC	
DRAWN BY	RZ	ACCOUNT NO.	
CHECKED BY	JF	235 C77K	
PHASE	D	COMMONWEALTH OF KENTUCKY FINANCE AND ADMINISTRATION CABINET DEPARTMENT FOR FACILITIES & SUPPORT SERVICES DIVISION OF ENGINEERING AND CONTRACT ADMINISTRATION FRANKFORT, KENTUCKY	
RTA DATE		AS BUILT DATE	
		DECA LOG #	
		T210C	
		SM&W SHEN MILSOM WILKE	
		REVISION HISTORY OF THIS DRAWING	
		DESCRIPTION OF REVISIONS DATE DESCRIPTION OF REVISIONS DATE	
		100 CONSOLIDATED CONSTRUCTION SET 05/22/17	
		101 PR# 9/20/2017	

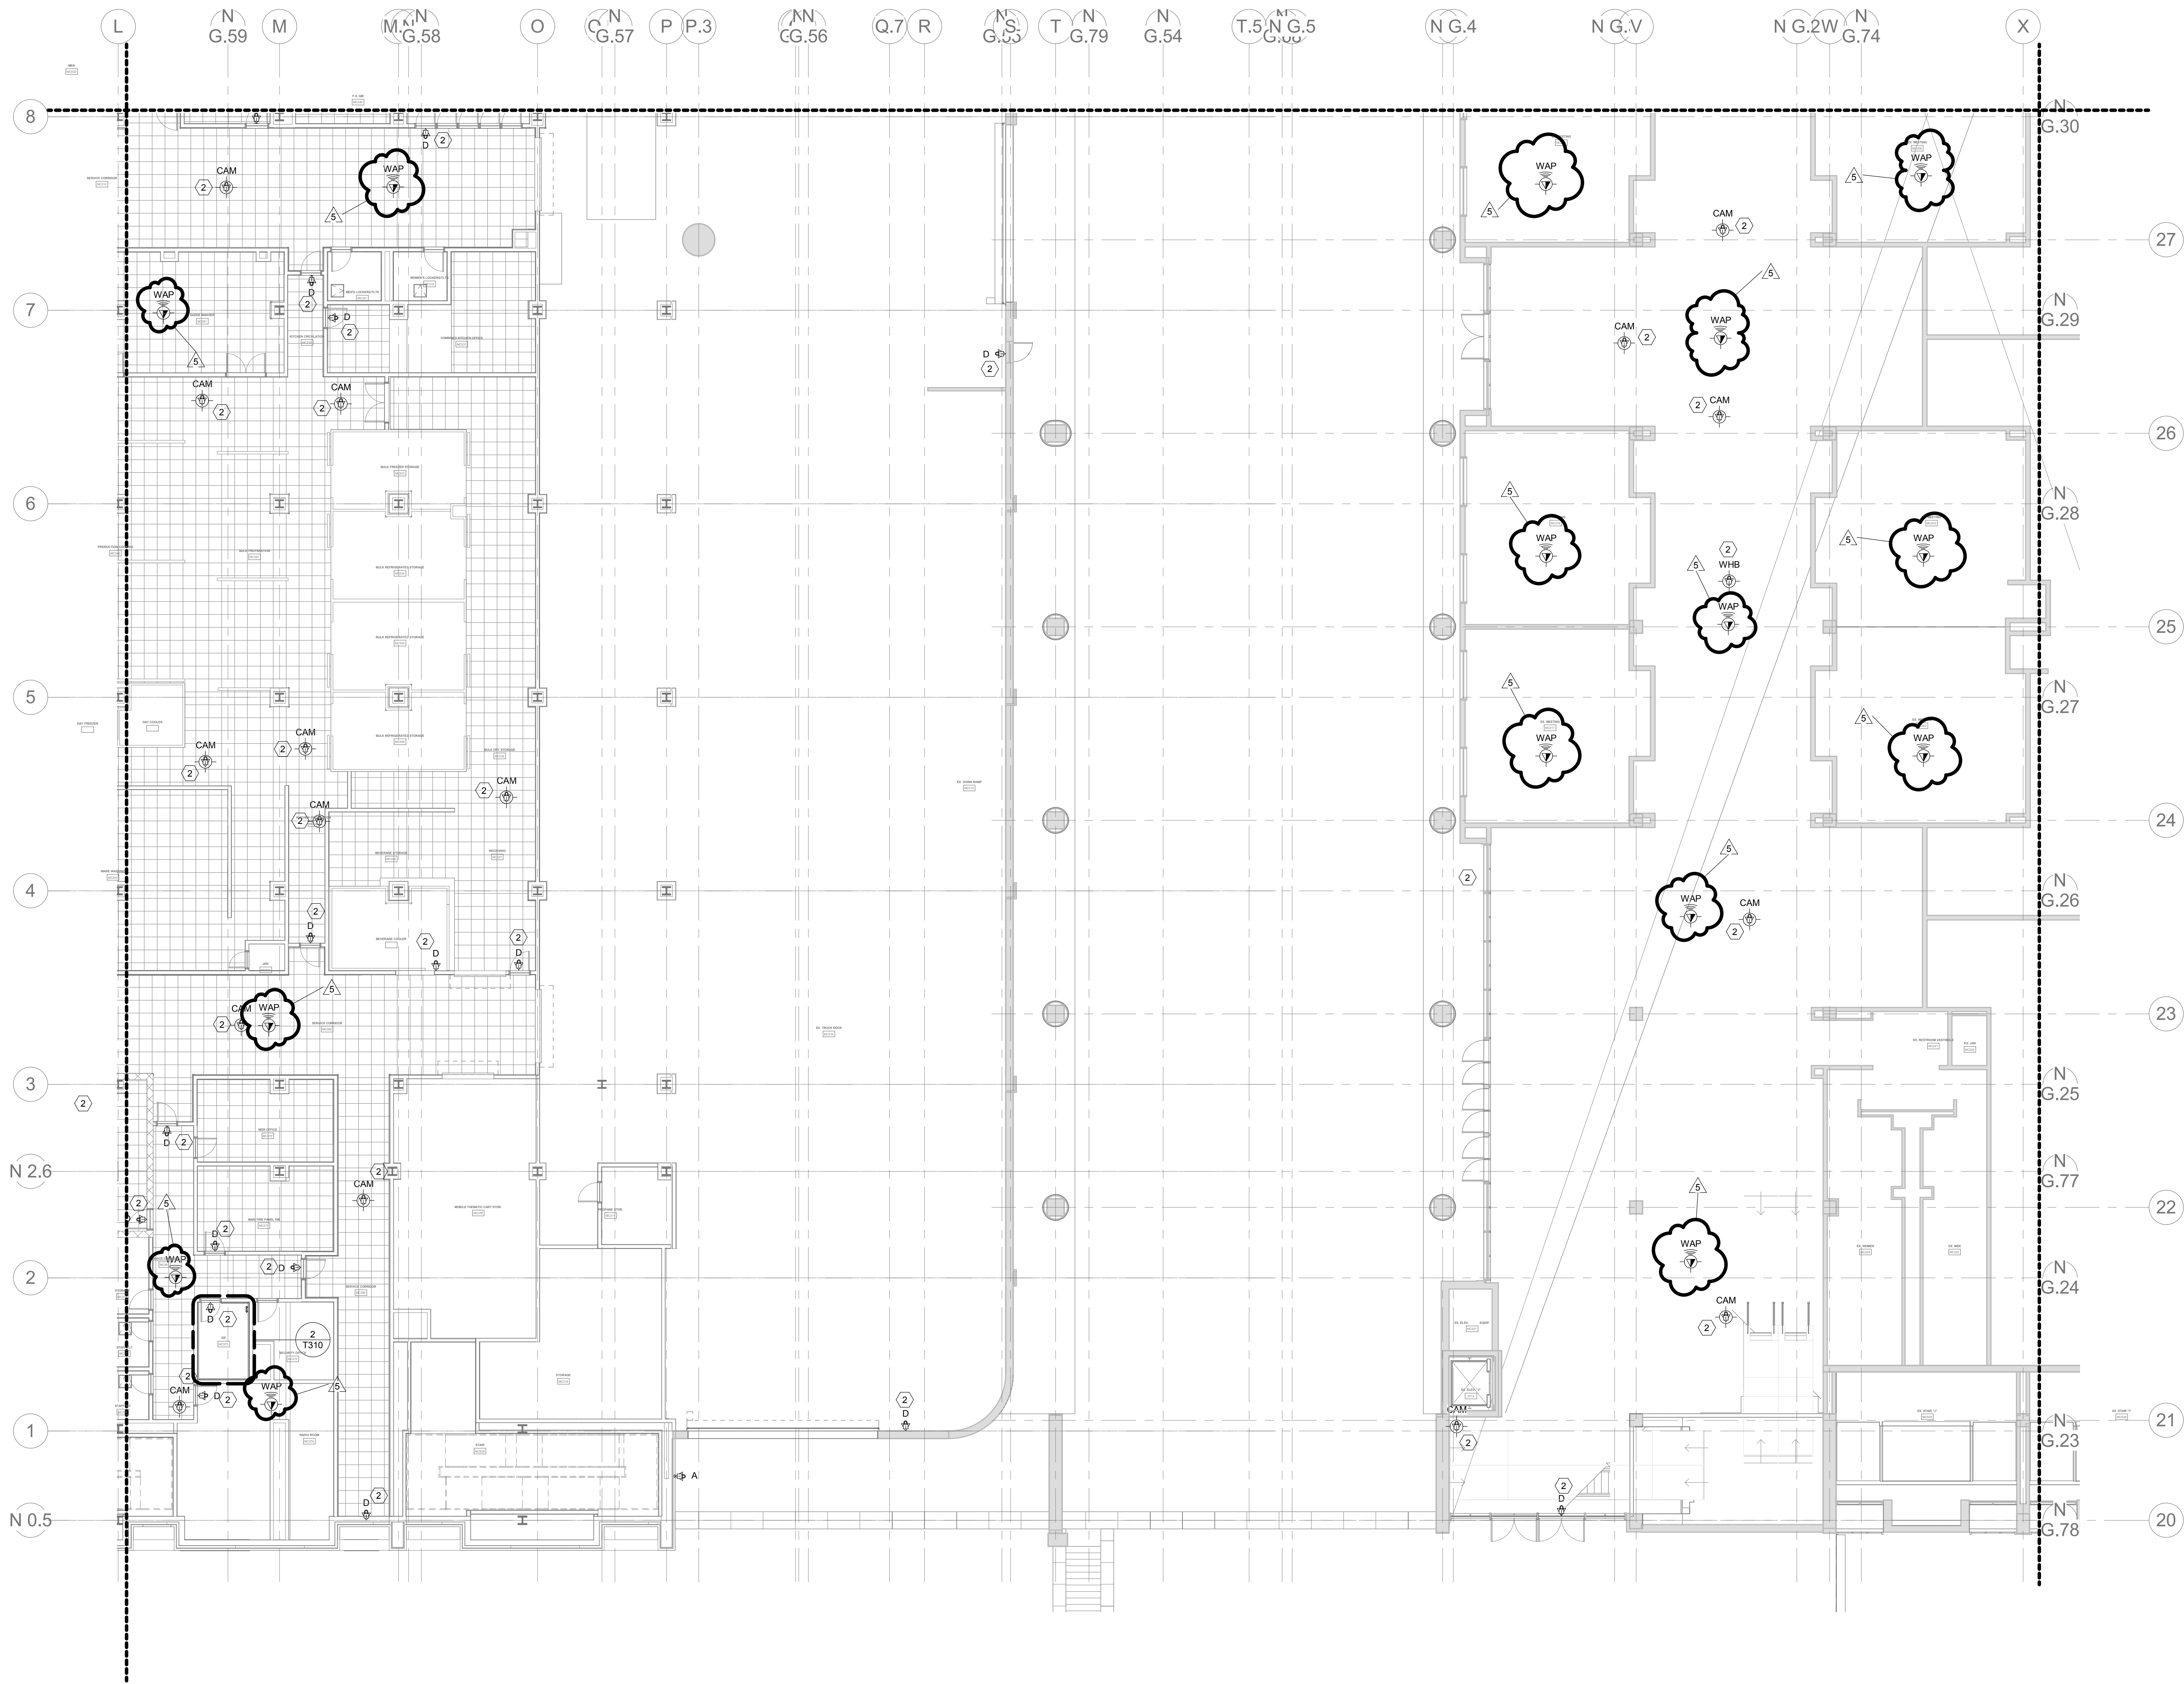




- SHEET NOTES: (7)
1. REFER TO AV DRAWINGS FOR ADDITIONAL INFORMATION
 2. REFER TO SECURITY DRAWINGS FOR ADDITIONAL INFORMATION.
 3. REFER TO SECURITY DRAWINGS FOR ADDITIONAL INFORMATION.
 4. INSTALL ELEVATOR CABLING TO THE CORRESPONDING ELEVATOR MACHINE ROOM

1 TELECOM MAIN CONCOURSE - AREA SC
3/32" = 1'-0"

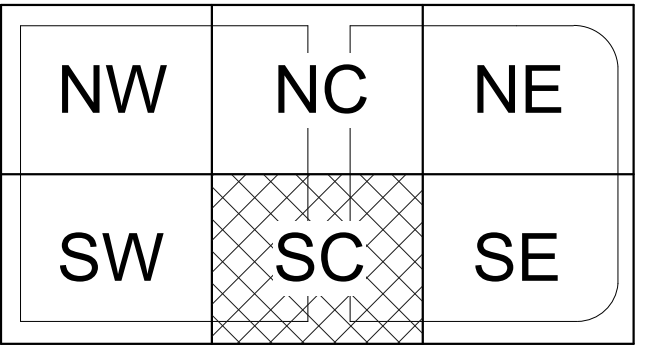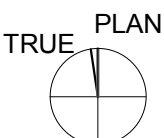KEYPLAN




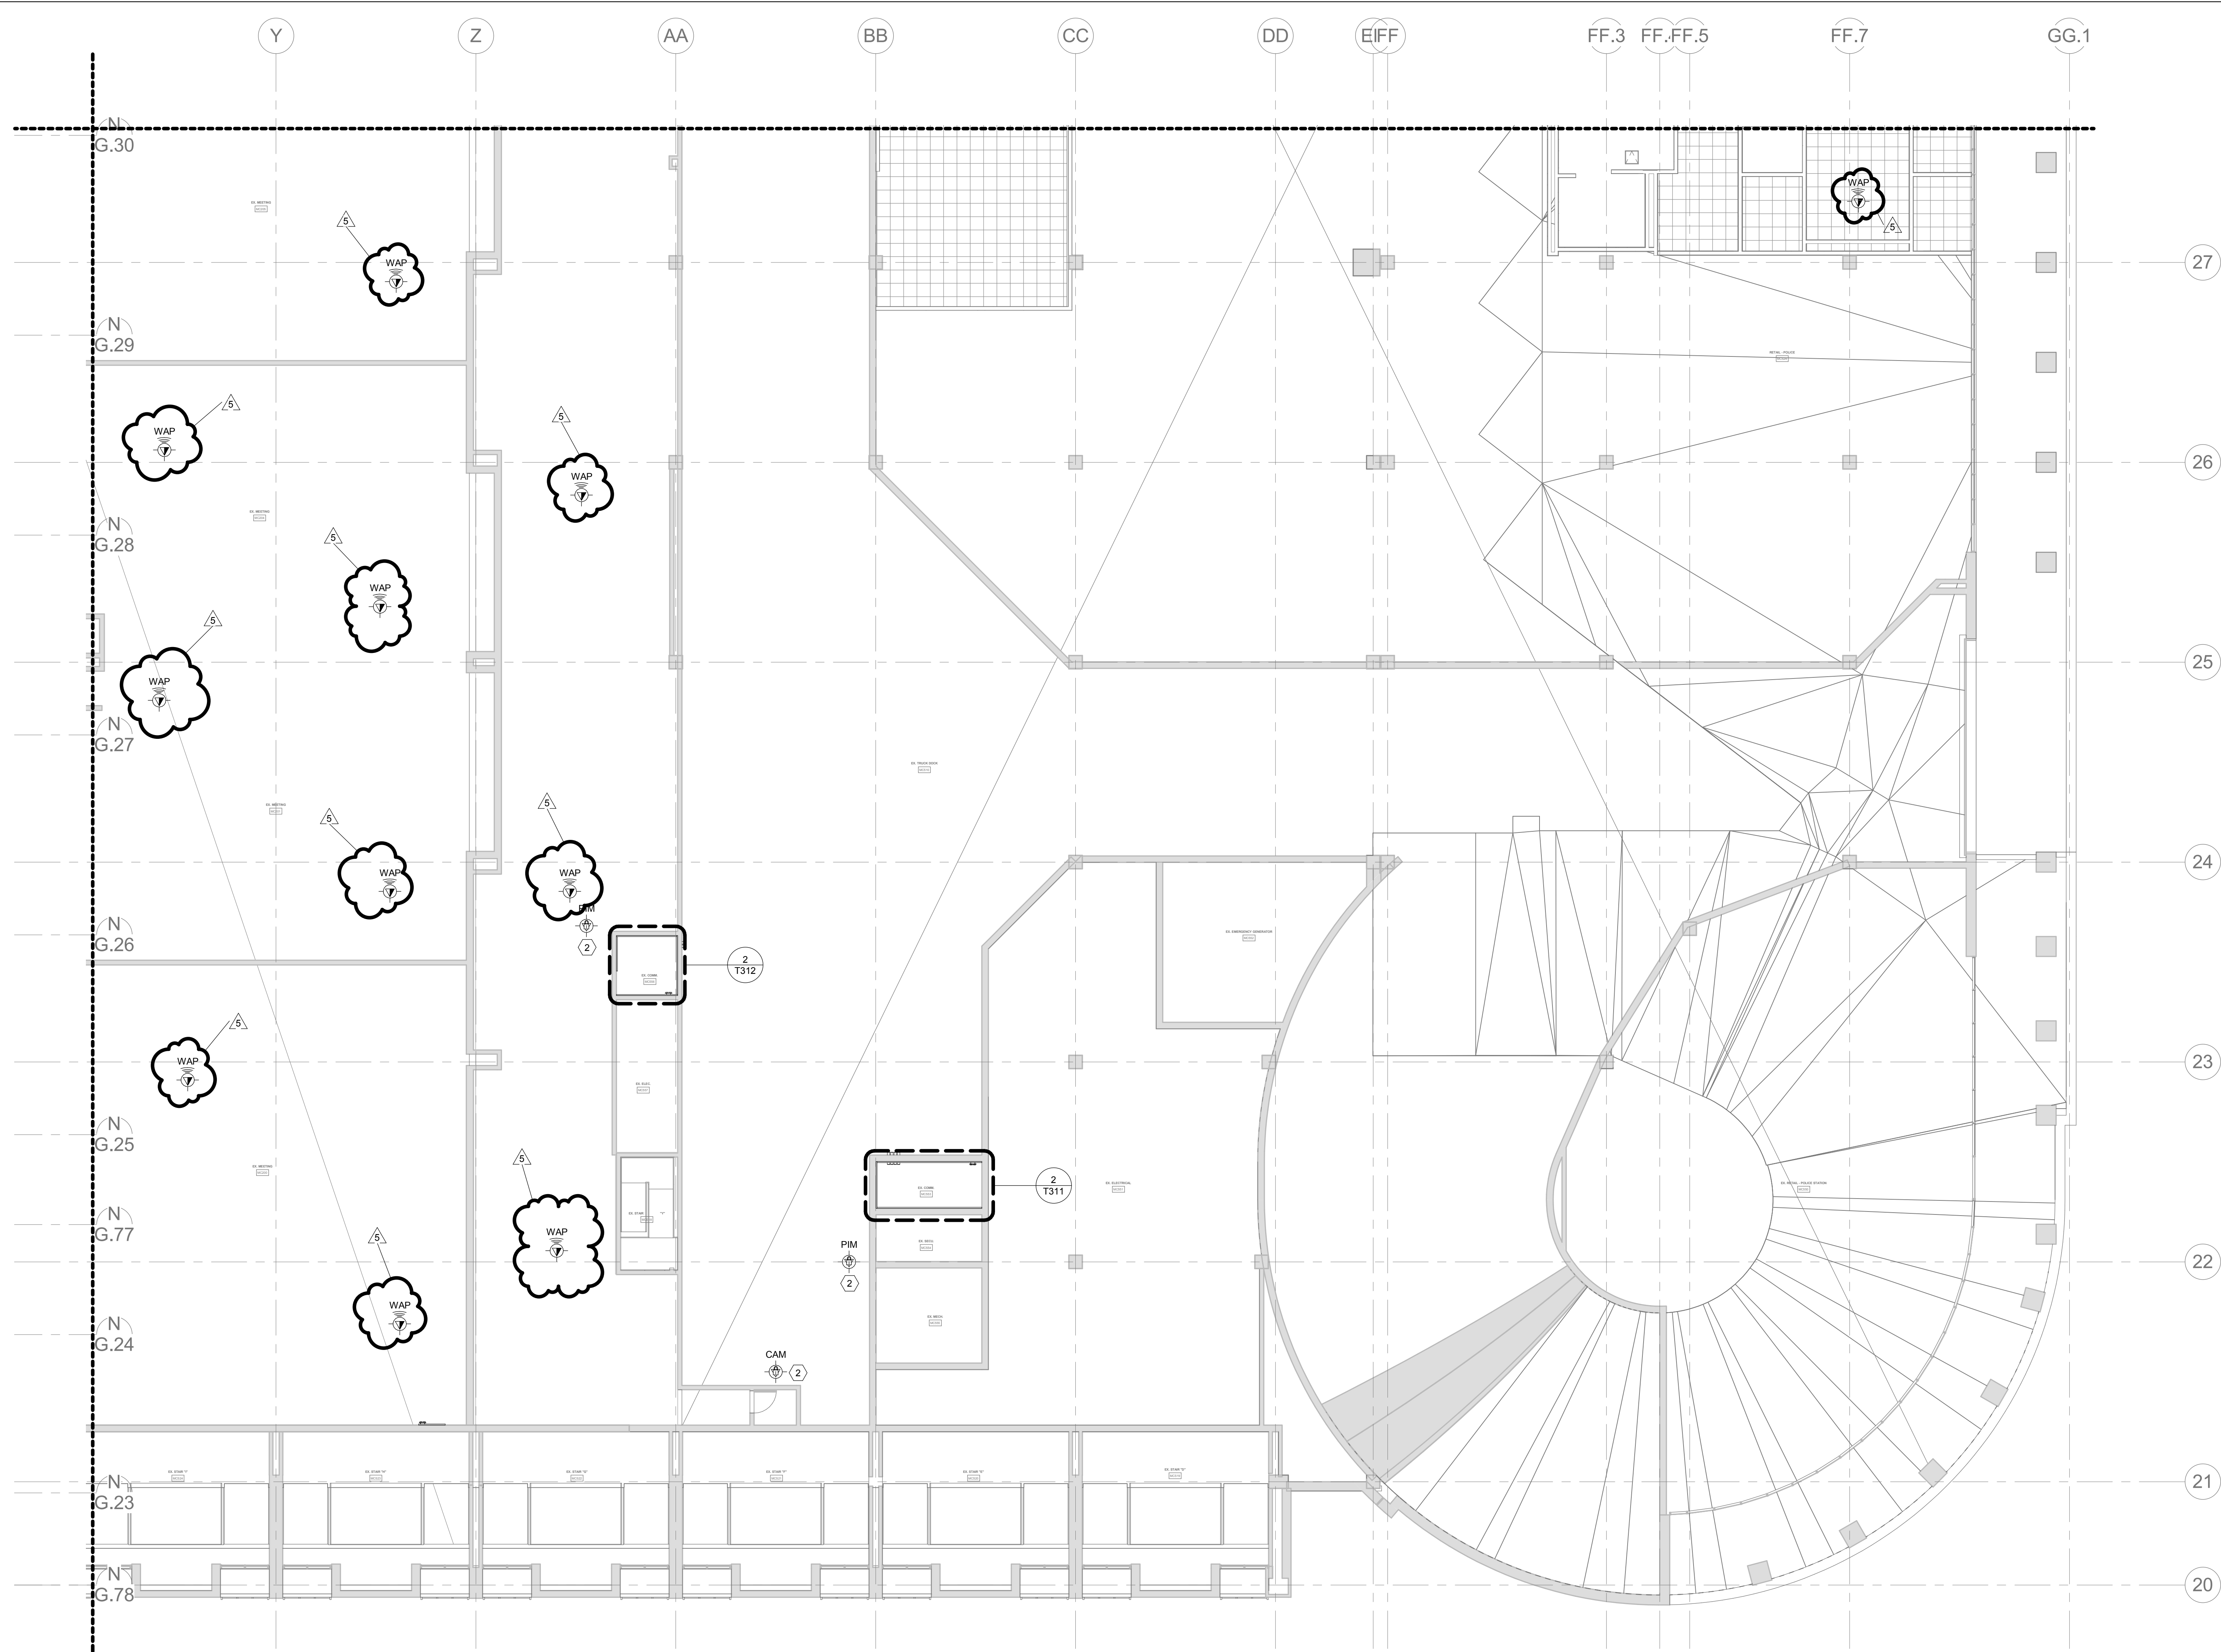

DRAWING INFORMATION		KENTUCKY INTERNATIONAL CONVENTION CENTER RENOVATION AND EXPANSION				DRAWING NO. T210D
A&E FILE NO.	14.03019.00	TELECOM MAIN CONCOURSE RCP - AREA SC				
DRAWING DATE	09/19/16	ACCOUNT NO.	COMMONWEALTH OF KENTUCKY FINANCE AND ADMINISTRATION CABINET DEPARTMENT FOR FACILITIES & SUPPORT SERVICES DIVISION OF ENGINEERING AND CONTRACT ADMINISTRATION FRANKFORT, KENTUCKY			AS BUILT DATE
DRAWN BY	RZ	235 C77K	 architecture interiors			
CHECKED BY	JF					
PHASE	D	 SM&W				REVISION HISTORY OF THIS DRAWING
RTA DATE						
		</				




- SHEET NOTES:**
1. REFER TO AV DRAWINGS FOR ADDITIONAL INFORMATION.
 2. REFER TO SECURITY DRAWINGS FOR ADDITIONAL INFORMATION.

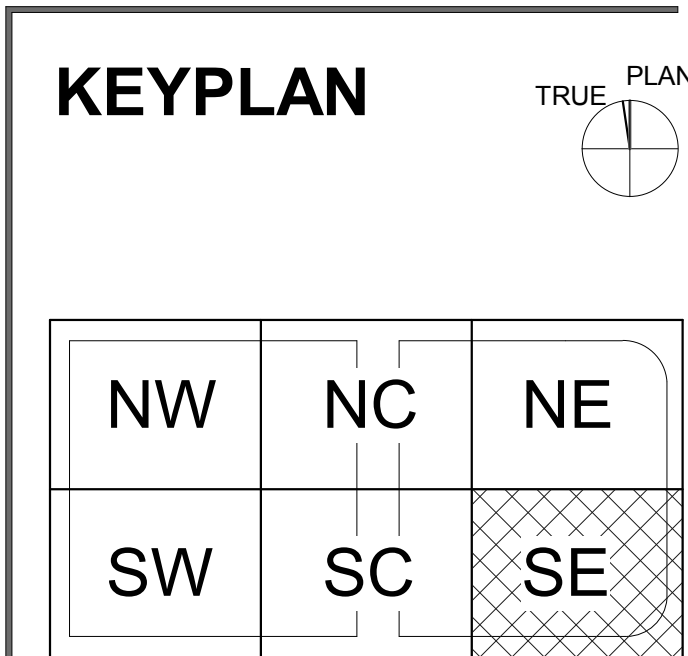1 TELECOM MAIN CONCOURSE - AREA SE
3/32" = 1'-0"




DRAWING INFORMATION		KENTUCKY INTERNATIONAL CONVENTION CENTER RENOVATION AND EXPANSION			
A&E FILE NO.	14.03019.00	TELECOM MAIN CONCOURSE RCP - AREA SE		DRAWING NO.	
DRAWING DATE	09/19/16			T210F	
DRAWN BY	RZ	ACCOUNT NO.	COMMONWEALTH OF KENTUCKY FINANCE AND ADMINISTRATION CABINET DEPARTMENT FOR FACILITIES & SUPPORT SERVICES DIVISION OF ENGINEERING AND CONTRACT ADMINISTRATION FRANKFORT, KENTUCKY		
CHECKED BY	JF	235 C77K			
PHASE	D				
RTA DATE					
 SM&W SHEN MILSOM WILKE				AS BUILT DATE	
				DECA LOG #	
		REVISION HISTORY OF THIS DRAWING			
DESCRIPTION OF REVISIONS		DATE	DESCRIPTION OF REVISIONS		DATE
100	CONSOLIDATED CONSTRUCTION SET	05/22/17			
101	PR#	9/20/2017			

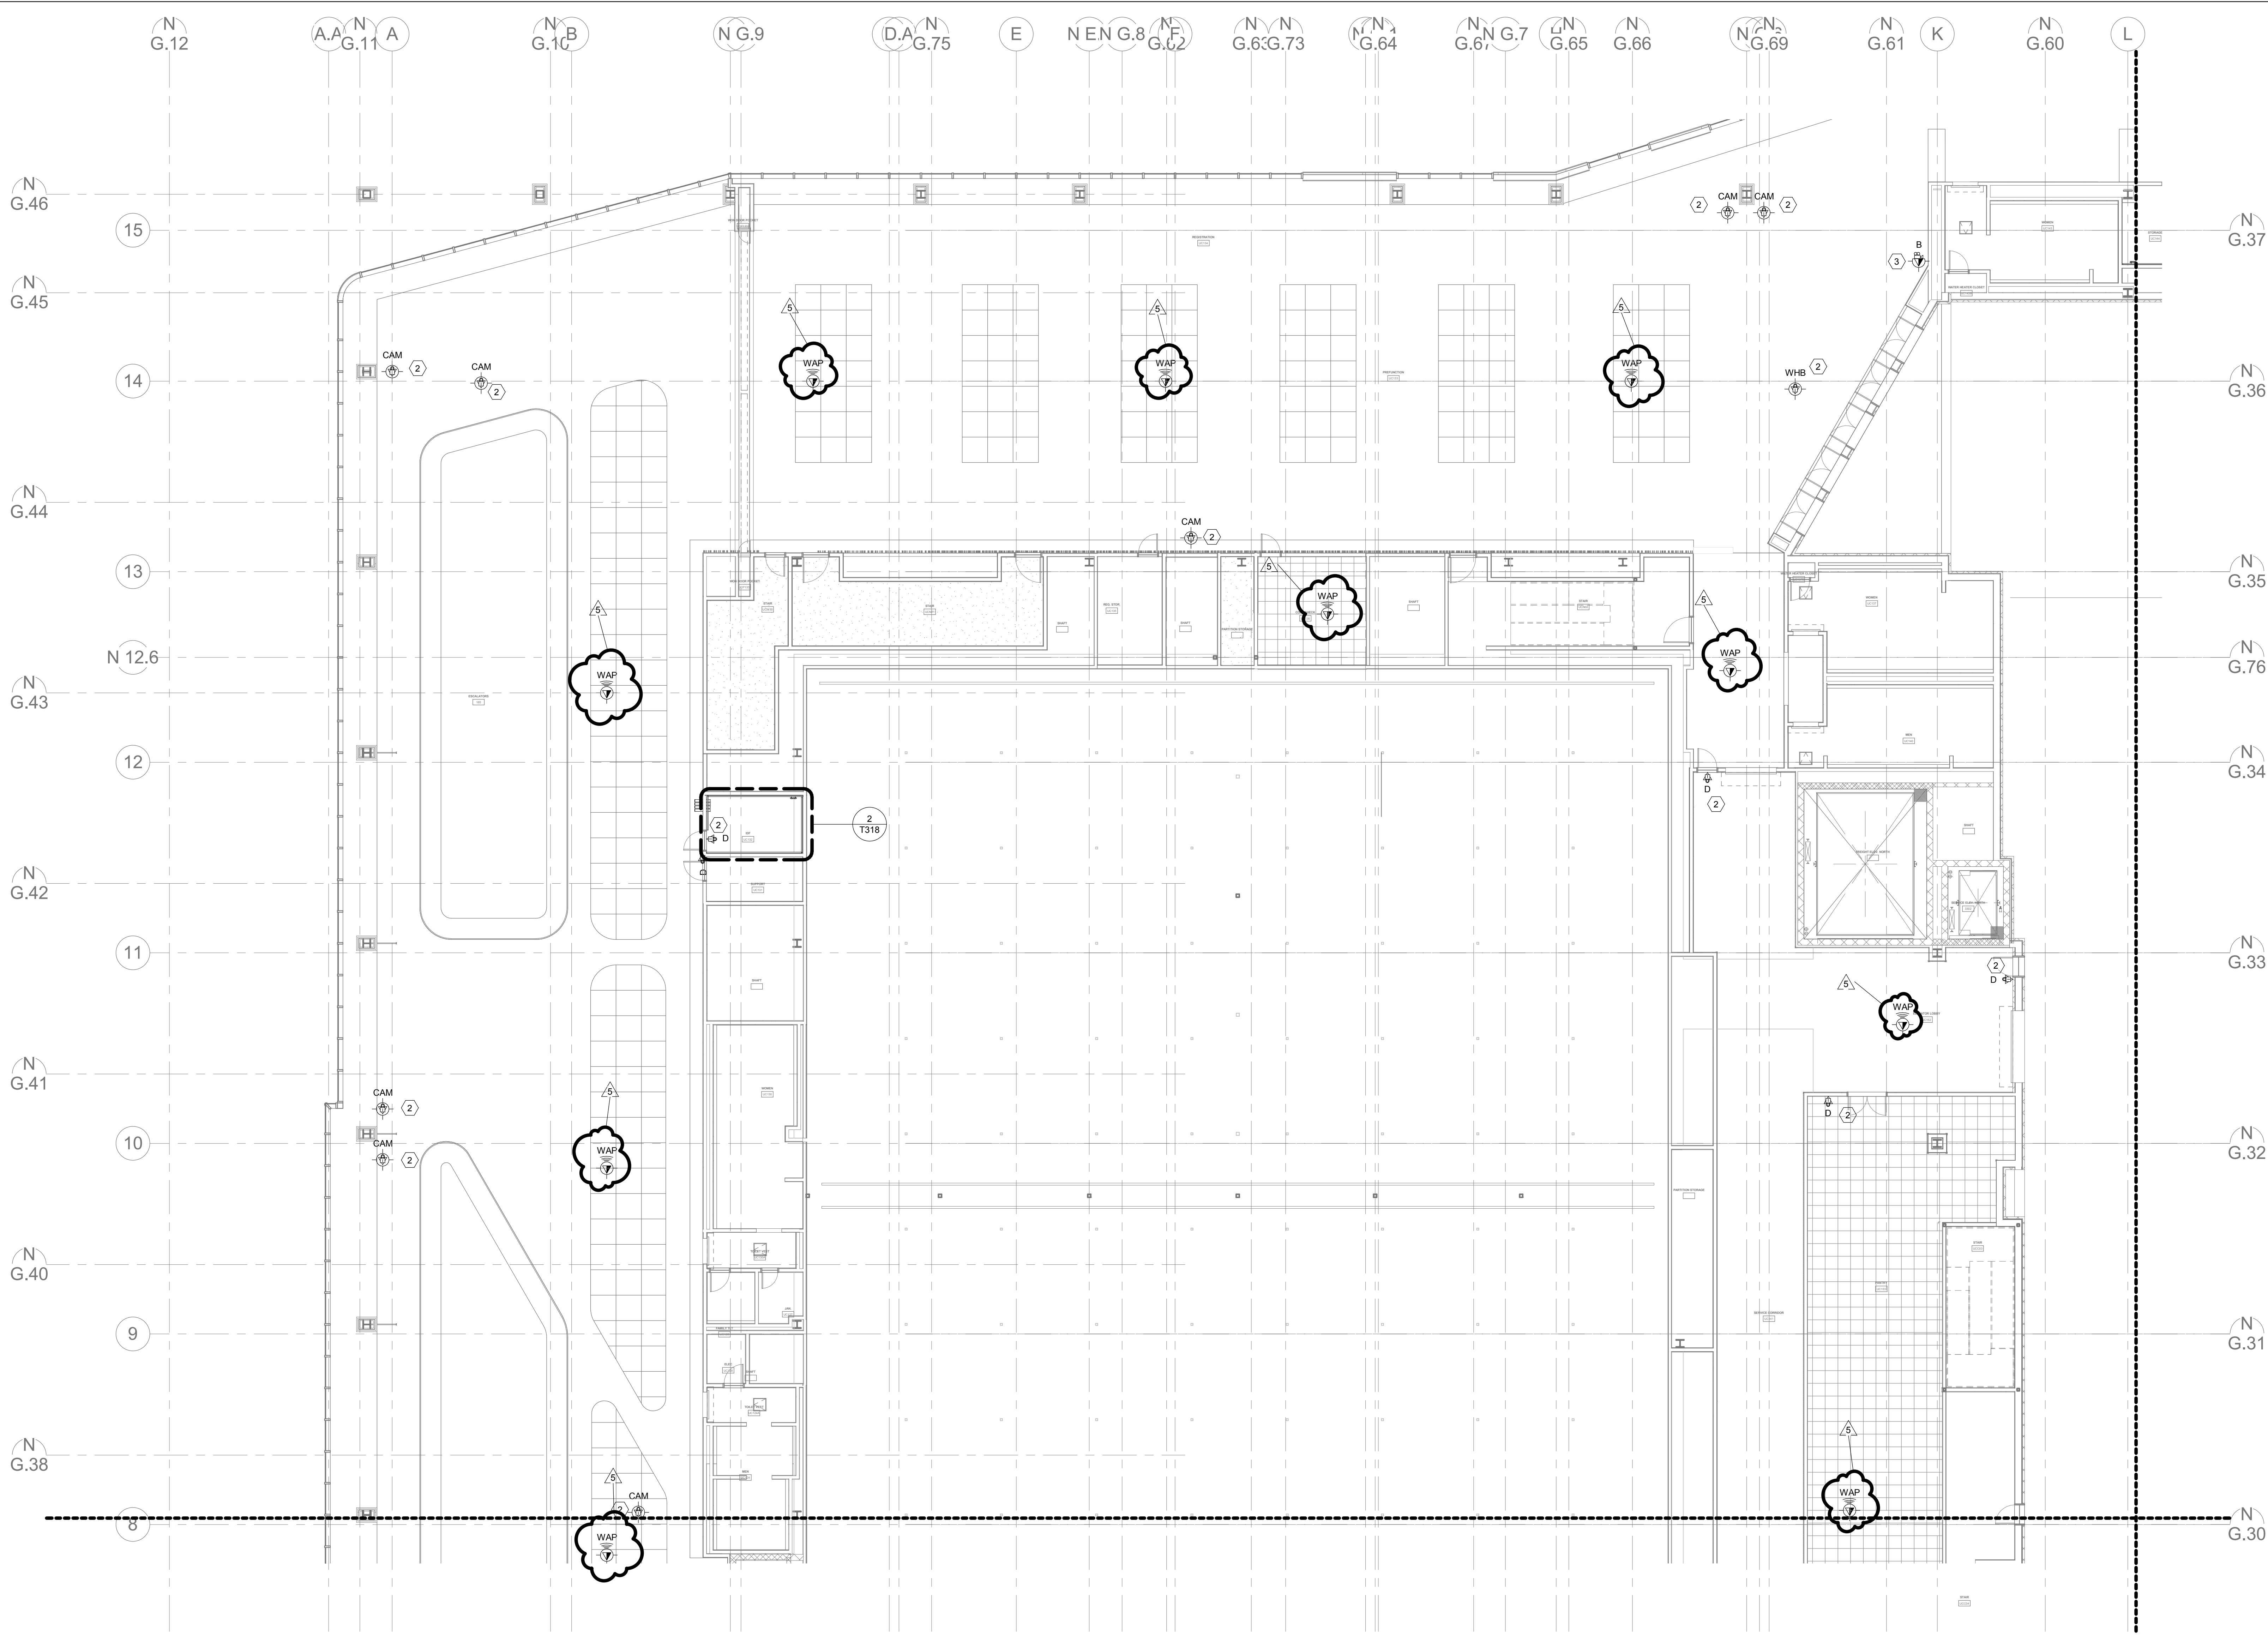



- SHEET NOTES: (8)
1. REFER TO AV DRAWINGS FOR ADDITIONAL INFORMATION
 2. REFER TO SECURITY DRAWINGS FOR ADDITIONAL INFORMATION.
 3. CABLES ARE FOR FUTURE DIGITAL MEETING ROOM SCHEDULE DISPLAYS.


1 TELECOM UPPER CONCOURSE - AREA NW
3/32" = 1'-0"

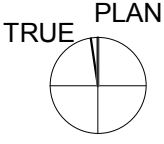KEYPLAN



NW	NC	NE
SW	SC	SE

DRAWING INFORMATION		KENTUCKY INTERNATIONAL CONVENTION CENTER RENOVATION AND EXPANSION				DRAWING NO. T220A
A&E FILE NO.	14.03019.00	TELECOM UPPER CONCOURSE RCP - AREA NW				
DRAWING DATE	09/19/16	ACCOUNT NO. 235 C77K	COMMONWEALTH OF KENTUCKY FINANCE AND ADMINISTRATION CABINET DEPARTMENT FOR FACILITIES & SUPPORT SERVICES DIVISION OF ENGINEERING AND CONTRACT ADMINISTRATION FRANKFORT, KENTUCKY			AS BUILT DATE DECA LOG #
DRAWN BY	RZ					
CHECKED BY	JF	 architecture interiors				
PHASE	D					
RTA DATE						
		DESCRIPTION OF REVISIONS		DATE	DESCRIPTION OF REVISIONS	DATE
100		CONSOLIDATED CONSTRUCTION SET		05/22/17		
101		PR#		9/20/2017		

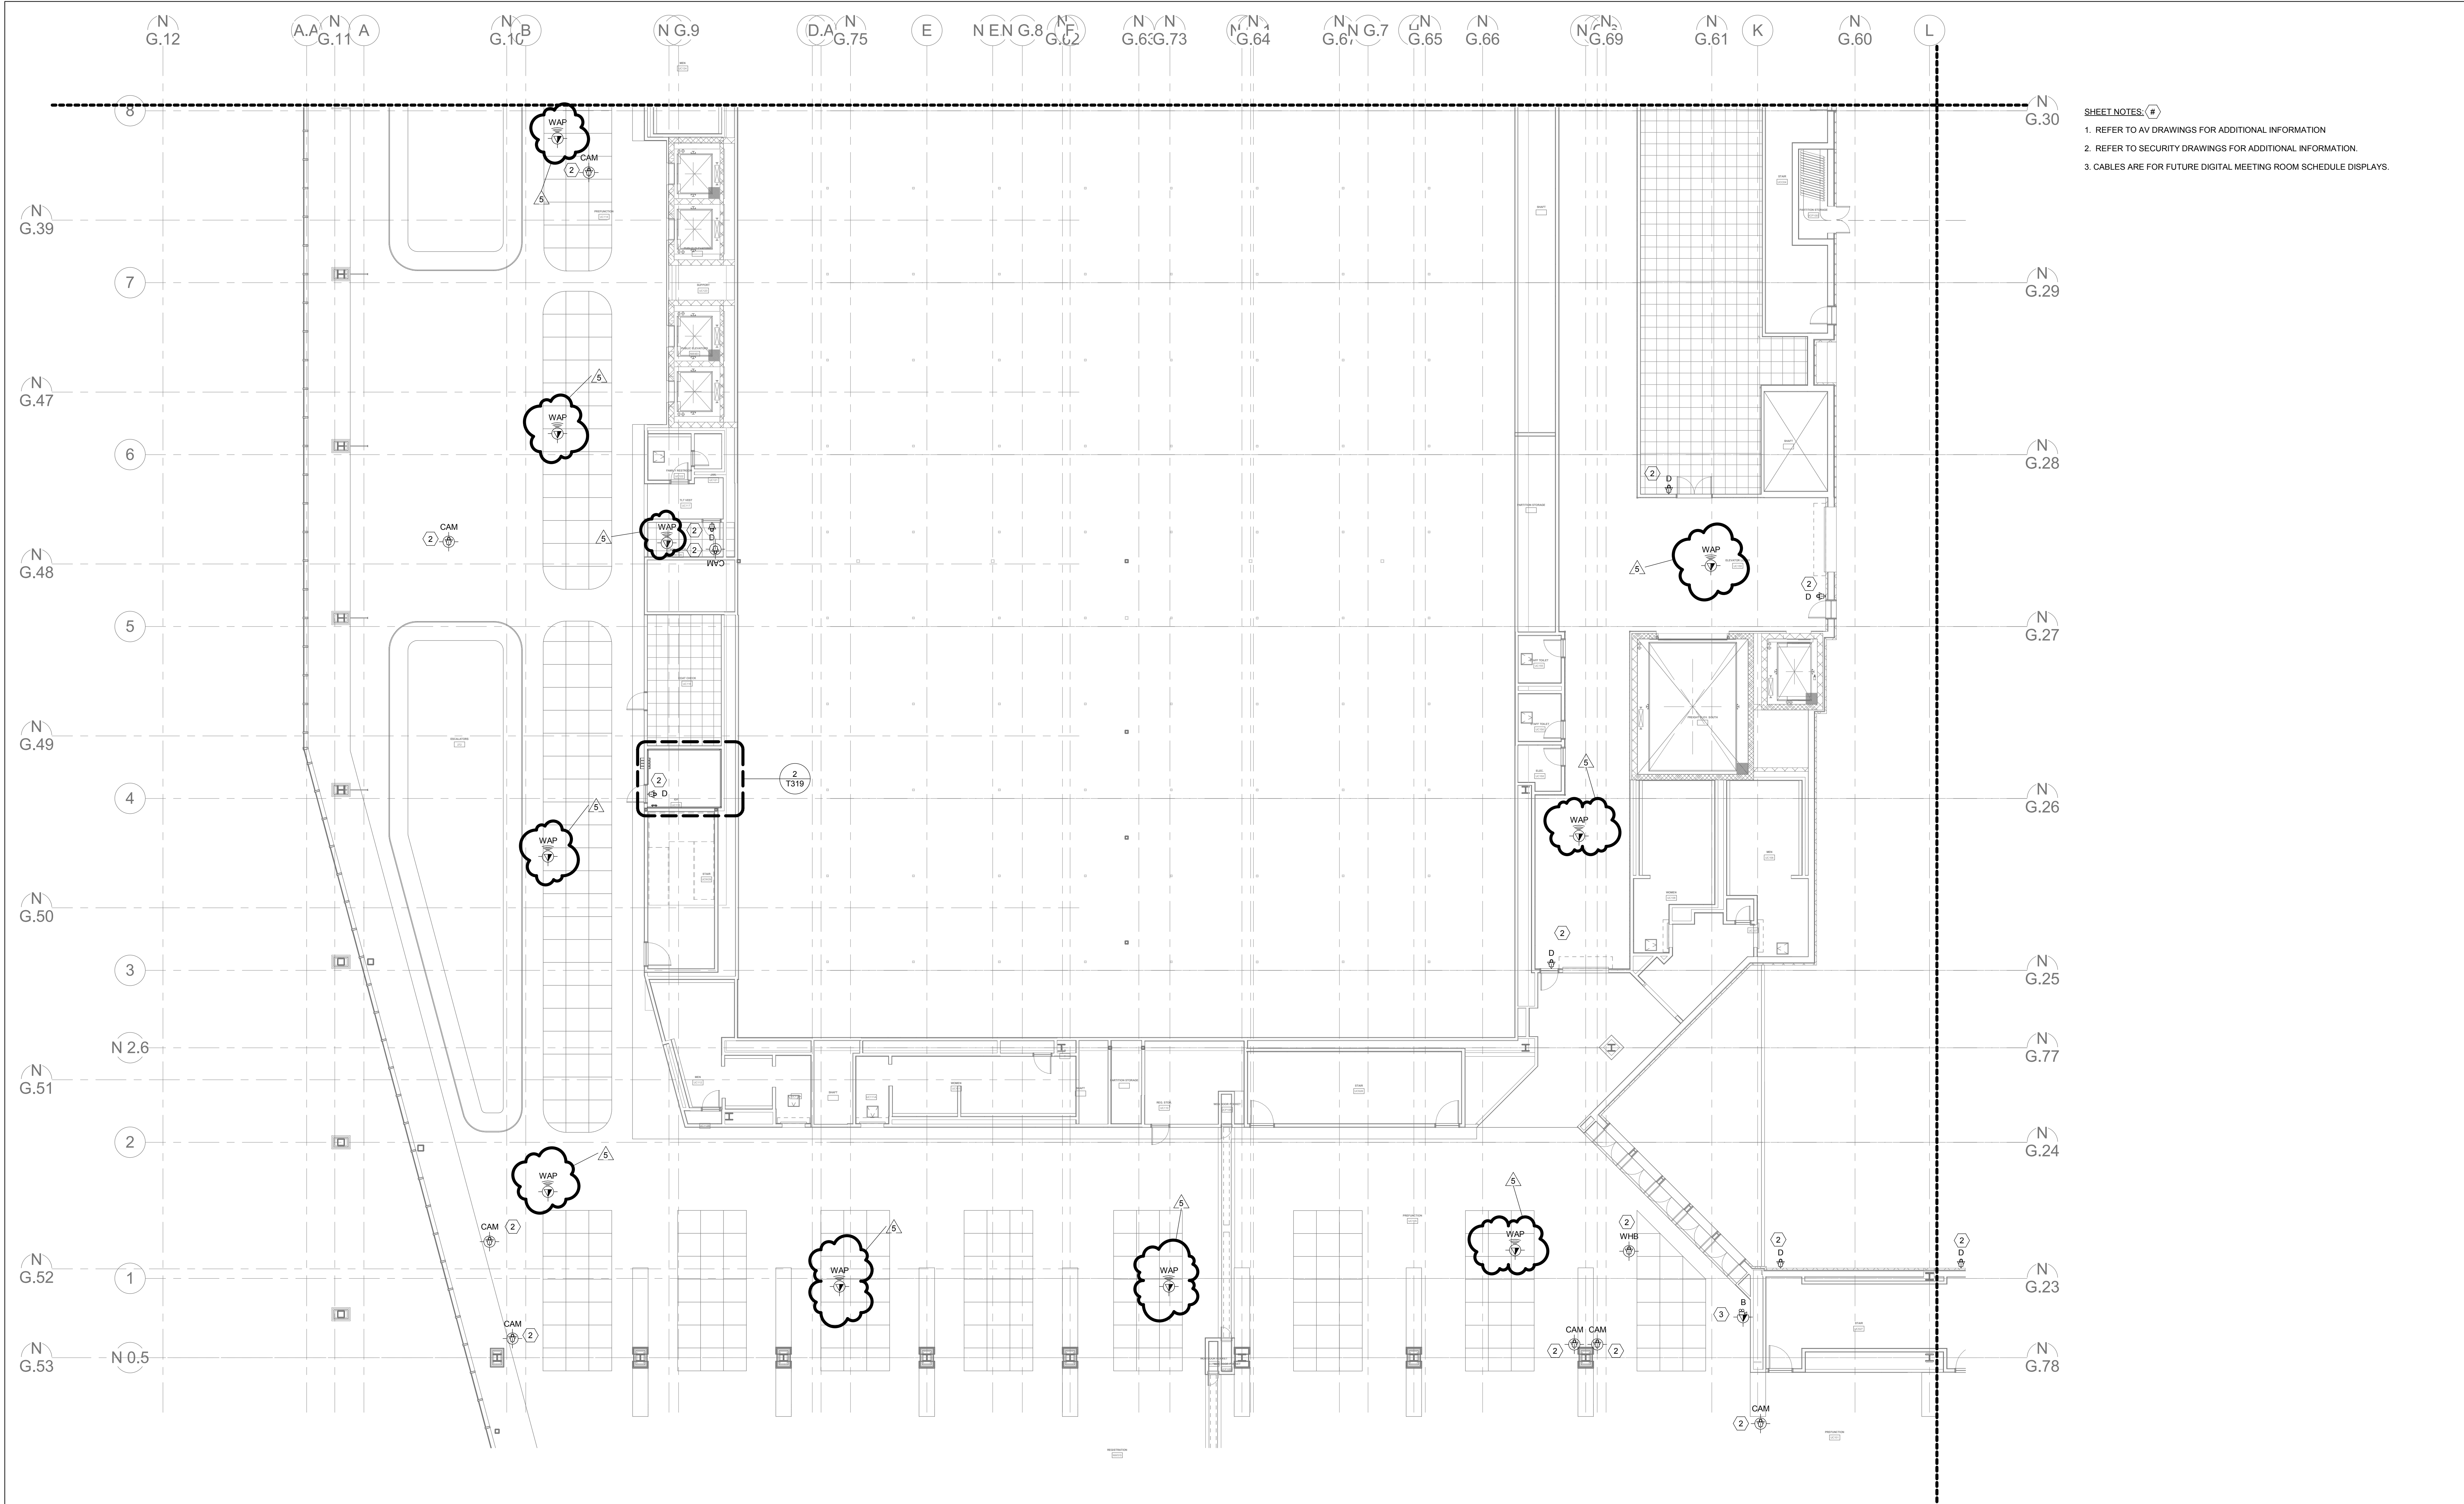



- SHEET NOTES: (#)
1. REFER TO AV DRAWINGS FOR ADDITIONAL INFORMATION
 2. REFER TO SECURITY DRAWINGS FOR ADDITIONAL INFORMATION.
 3. CABLES ARE FOR FUTURE DIGITAL MEETING ROOM SCHEDULE DISPLAYS.

1 TELECOM UPPER CONCOURSE - AREA SW
3/32" = 1'-0"

KEYPLAN


TRUE PLAN




NW	NC	NE
SW	SC	SE


DRAWING INFORMATION		KENTUCKY INTERNATIONAL CONVENTION CENTER RENOVATION AND EXPANSION															
A&E FILE NO.	14.03019.00	TELECOM UPPER CONCOURSE RCP - AREA SW		DRAWING NO.													
DRAWING DATE	09/19/16	<div>ACCOUNT NO. 235 C77K</div> <div>COMMONWEALTH OF KENTUCKY FINANCE AND ADMINISTRATION CABINET DEPARTMENT FOR FACILITIES & SUPPORT SERVICES DIVISION OF ENGINEERING AND CONTRACT ADMINISTRATION FRANKFORT, KENTUCKY</div> <div> architecture interior</div>		<div>T220B</div> <div>AS BUILT DATE</div> <div>DECA LOG #</div>													
DRAWN BY	RZ																
CHECKED BY	JF																
PHASE	D																
RTA DATE																	
<div> SM&W ARCHITECTURAL FIRM, INC.</div>		<div>REVISION HISTORY OF THIS DRAWING</div> <table><thead><tr><th>DESCRIPTION OF REVISIONS</th><th>DATE</th><th>DESCRIPTION OF REVISIONS</th><th>DATE</th></tr></thead><tbody><tr><td>100 CONSOLIDATED CONSTRUCTION SET</td><td>05/22/17</td><td></td><td></td></tr><tr><td>101 PR#</td><td>9/20/2017</td><td></td><td></td></tr></tbody></table>				DESCRIPTION OF REVISIONS	DATE	DESCRIPTION OF REVISIONS	DATE	100 CONSOLIDATED CONSTRUCTION SET	05/22/17			101 PR#	9/20/2017		
DESCRIPTION OF REVISIONS	DATE	DESCRIPTION OF REVISIONS	DATE														
100 CONSOLIDATED CONSTRUCTION SET	05/22/17																
101 PR#	9/20/2017																



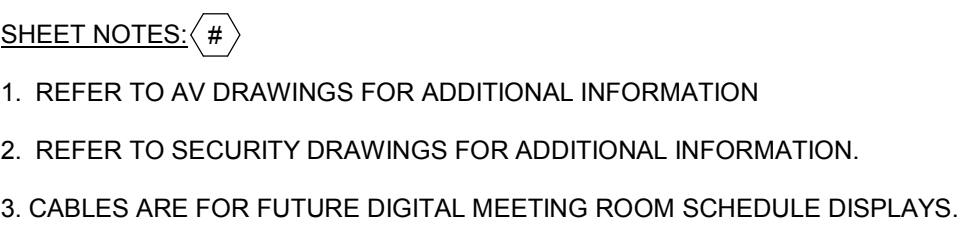


DRAWING NO.
T220B
AS BUILT DATE
DECA LOG #

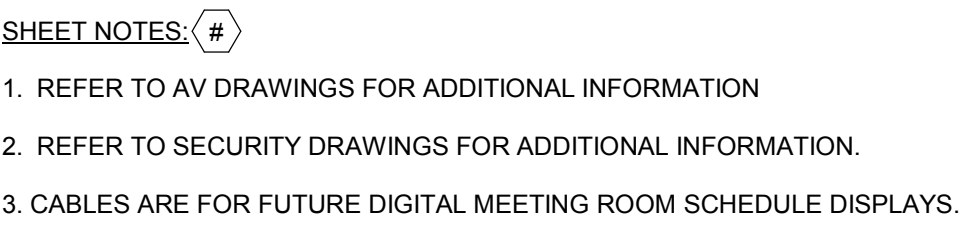

DRAWING INFORMATION		<h1 style="text-align: center;">KENTUCKY INTERNATIONAL CONVENTION CENTER</h1> <h2 style="text-align: center;">RENOVATION AND EXPANSION</h2>			
A&E FILE NO.	14.03019.00	<h3 style="text-align: center;">TELECOM UPPER CONCOURSE RCP - AREA NC</h3>			DRAWING NO.
DRAWING DATE	09/19/16				<div style="text-align: center;">  <p>architecture interiors</p> </div>
DRAWN BY	RZ	ACCOUNT NO.	COMMONWEALTH OF KENTUCKY FINANCE AND ADMINISTRATION CABINET		
CHECKED BY	JF	235 C77K	DEPARTMENT FOR FACILITIES & SUPPORT SERVICES DIVISION OF ENGINEERING AND CONTRACT ADMINISTRATION		
PHASE	D		FRANKFORT, KENTUCKY		
RTA DATE					AS BUILT DATE
					DECA LOG #
		<h3 style="text-align: center;">REVISION HISTORY OF THIS DRAWING</h3>			
		DESCRIPTION OF REVISIONS	DATE	DESCRIPTION OF REVISIONS	DATE
		100 CONSOLIDATED CONSTRUCTION SET	05/22/17		
		101 PR#	9/20/2017		
					
SHEN MILSOM WILKE					



DRAWING INFORMATION		<h1 style="text-align: center;">KENTUCKY INTERNATIONAL CONVENTION CENTER</h1> <h2 style="text-align: center;">RENOVATION AND EXPANSION</h2>				
A&E FILE NO.	14.03019.00	<h3 style="text-align: center;">TELECOM UPPER CONCOURSE RCP - AREA SC</h3>		DRAWING NO.		
DRAWING DATE	09/19/16			<div style="font-size: 48pt; font-weight: bold; text-align: center;">T220D</div>		
DRAWN BY	RZ	ACCOUNT NO.				
CHECKED BY	JF	235 C77K				
PHASE	D	COMMONWEALTH OF KENTUCKY FINANCE AND ADMINISTRATION CABINET DEPARTMENT FOR FACILITIES & SUPPORT SERVICES DIVISION OF ENGINEERING AND CONTRACT ADMINISTRATION FRANKFORT, KENTUCKY				
RTA DATE						
				AS BUILT DATE		
				DECA LOG #		
		REVISION HISTORY OF THIS DRAWING				
		DESCRIPTION OF REVISIONS		DATE	DESCRIPTION OF REVISIONS	DATE
		100 CONSOLIDATED CONSTRUCTION SET		05/22/17		
		101 PR#		9/20/2017		
						
SHEN MILSOM WILKE						

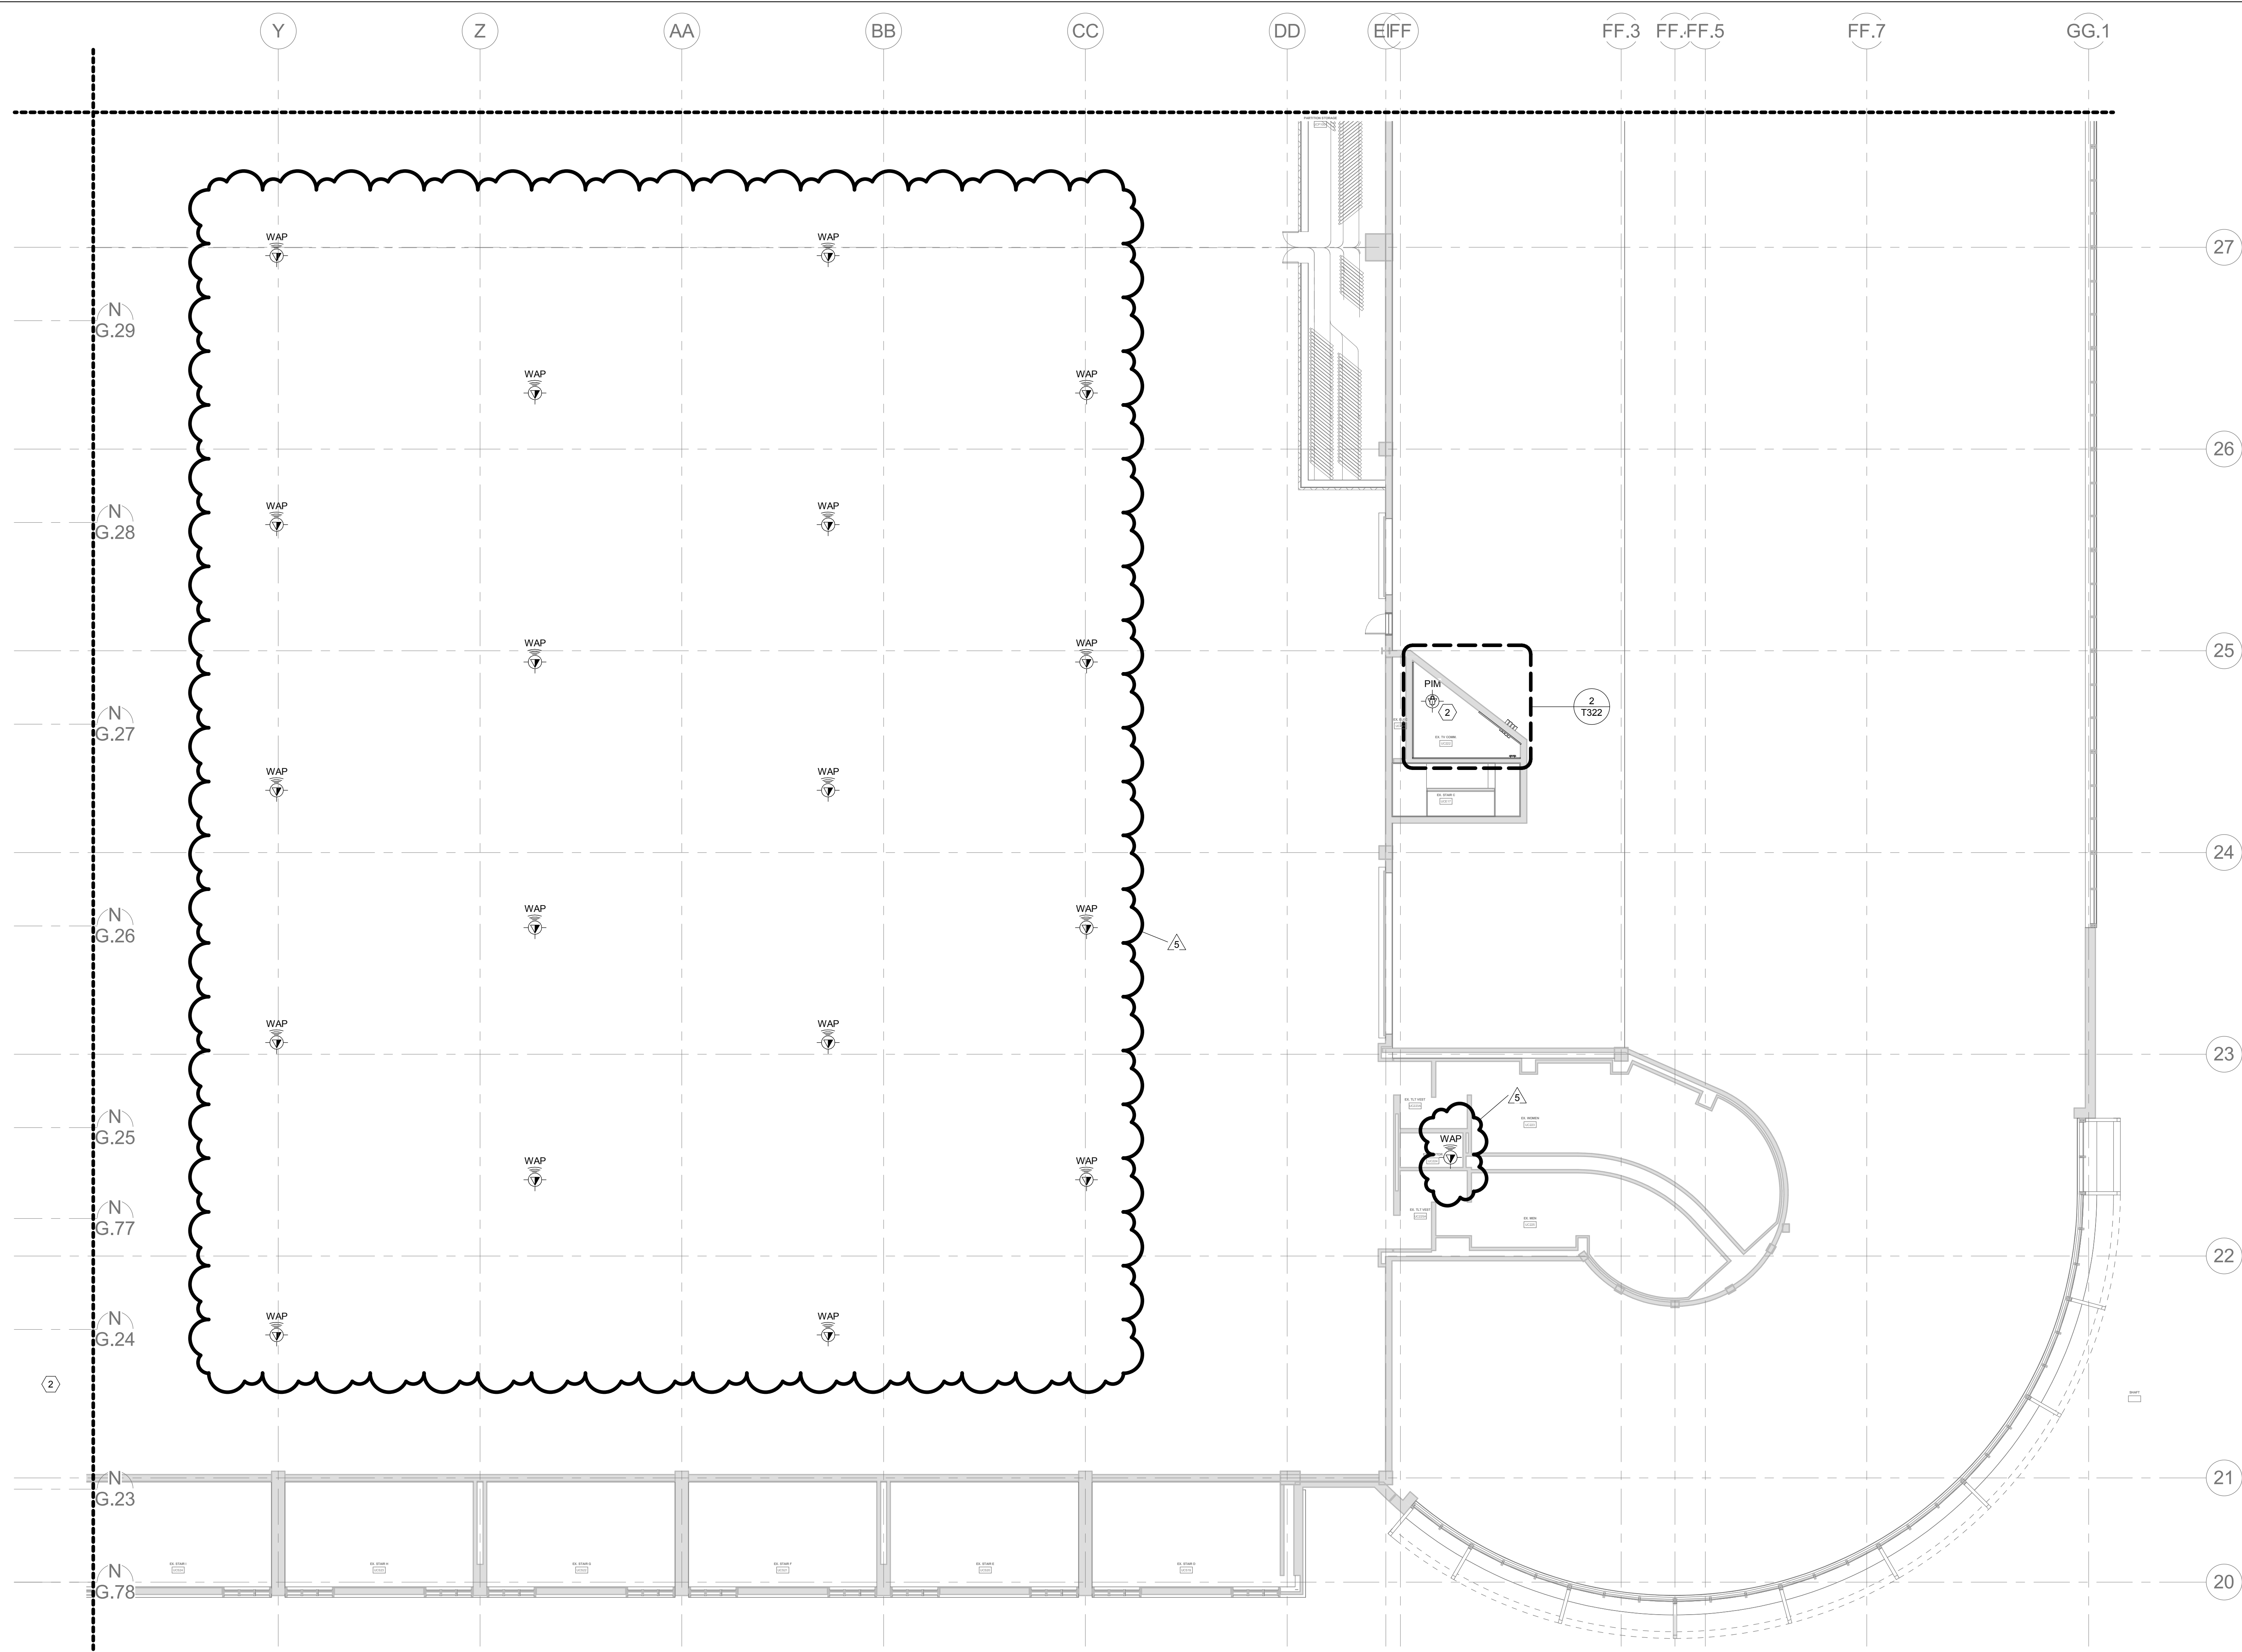

- SHEET NOTES: (#)
1. REFER TO AV DRAWINGS FOR ADDITIONAL INFORMATION
 2. REFER TO SECURITY DRAWINGS FOR ADDITIONAL INFORMATION.


1 TELECOM UPPER CONCOURSE - AREA SE
3/32" = 1'-0"

KEYPLAN

TRUE PLAN

NW	NC	NE
SW	SC	SE

DRAWING INFORMATION				KENTUCKY INTERNATIONAL CONVENTION CENTER RENOVATION AND EXPANSION			
A&E FILE NO.	14.03019.00	DRAWING NO.		TELECOM UPPER CONCOURSE RCP - AREA SE		DRAWING NO.	
DRAWING DATE	09/19/16	ACCOUNT NO.		COMMONWEALTH OF KENTUCKY FINANCE AND ADMINISTRATION CABINET DEPARTMENT FOR FACILITIES & SUPPORT SERVICES DIVISION OF ENGINEERING AND CONTRACT ADMINISTRATION FRANKFORT, KENTUCKY		T220F	
DRAWN BY	RZ	AS BUILT DATE		REVISION HISTORY OF THIS DRAWING		DECA LOG #	
CHECKED BY	JF	DATE		DESCRIPTION OF REVISIONS		DATE	
RTA DATE	D	DATE		DESCRIPTION OF REVISIONS		DATE	
SM&W SHEN MILSOM WILKE		100	CONSOLIDATED CONSTRUCTION SET	05/22/17			
		101	PR#	9/20/2017			

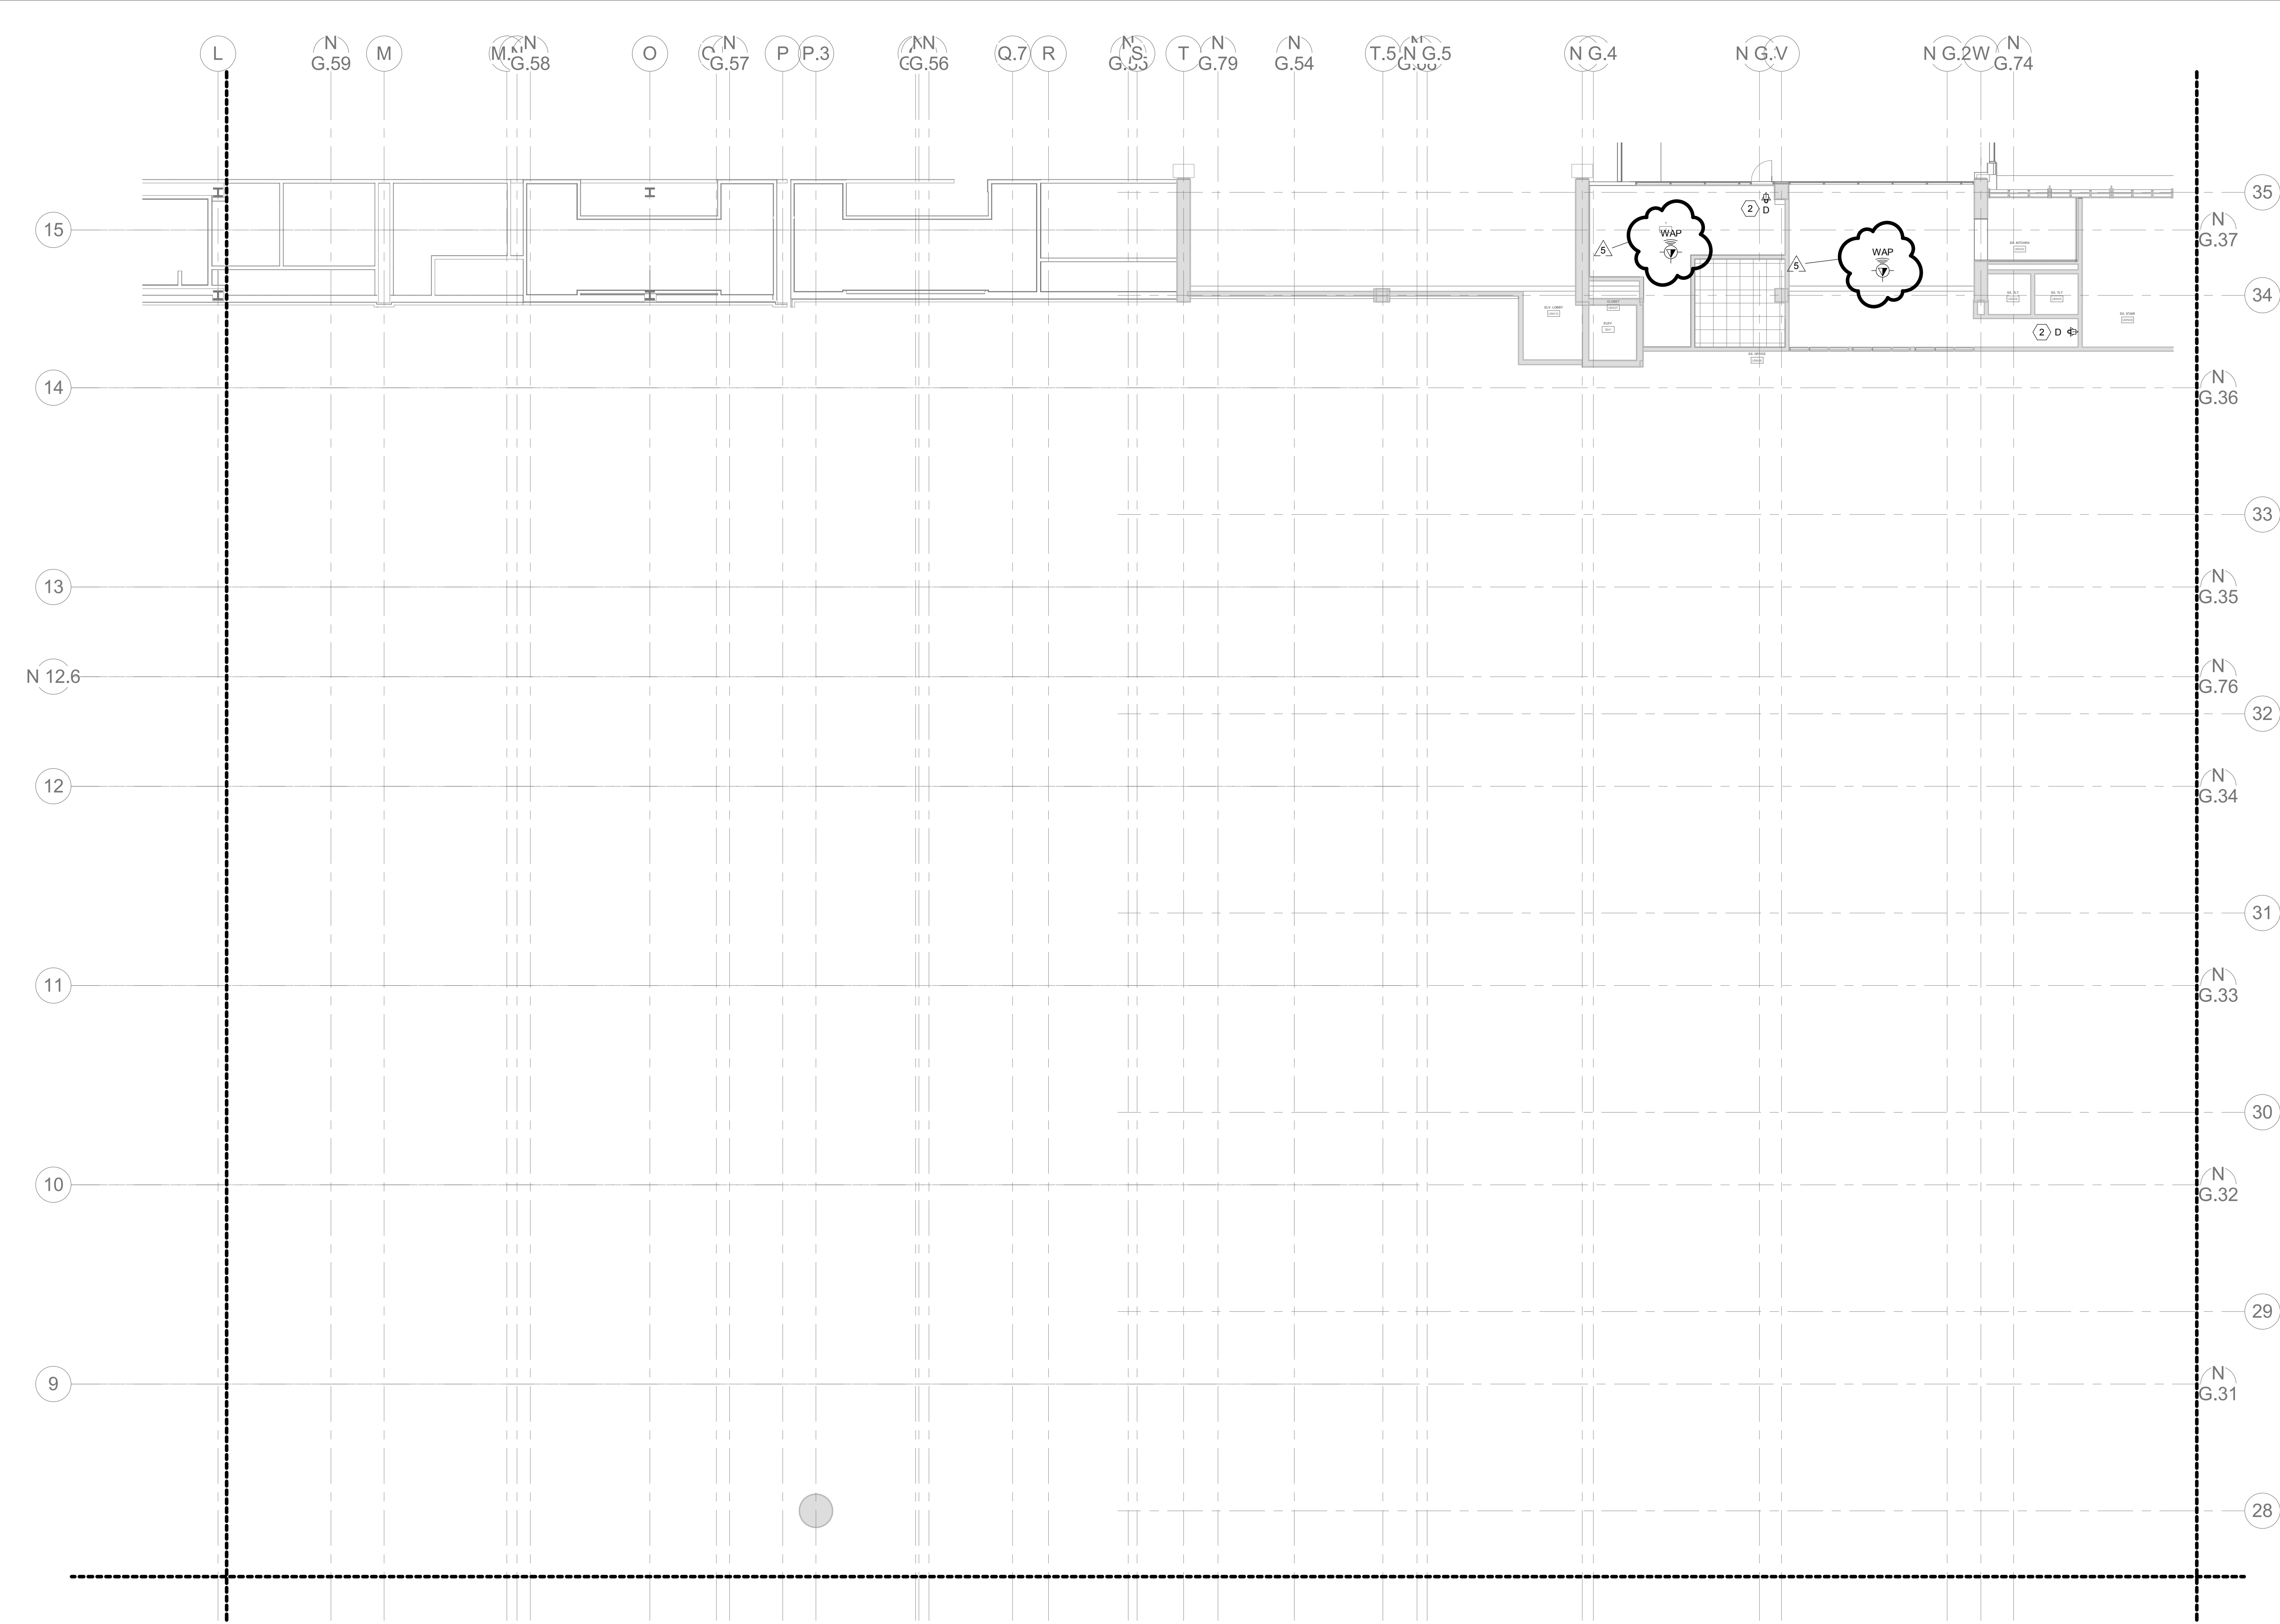

1 TELECOM UPPER MEZZANINE WEST - AREA NC
3/32" = 1'-0"

KEYPLAN

TRUE

PLAN

NW



NC


NE

SW

SC

SE

DRAWING INFORMATION		KENTUCKY INTERNATIONAL CONVENTION CENTER RENOVATION AND EXPANSION				
A&E FILE NO.	14.03019.00	TELECOM UPPER MEZZANINE RCP - AREA NC			DRAWING NO.	
DRAWING DATE	09/19/16				T230C	
DRAWN BY	Author	ACCOUNT NO.	COMMONWEALTH OF KENTUCKY FINANCE AND ADMINISTRATION CABINET DEPARTMENT FOR FACILITIES & SUPPORT SERVICES DIVISION OF ENGINEERING AND CONTRACT ADMINISTRATION FRANKFORT, KENTUCKY			
CHECKED BY	Checker	235 C77K				
PHASE	D					
RTA DATE					AS BUILT DATE	
 SHEN MILSOM WILKE					DECA LOG #	
		REVISION HISTORY OF THIS DRAWING				
		DESCRIPTION OF REVISIONS		DATE	DESCRIPTION OF REVISIONS	DATE
		100	CONSOLIDATED CONSTRUCTION SET	05/22/17		
		101	PR#	9/20/2017		

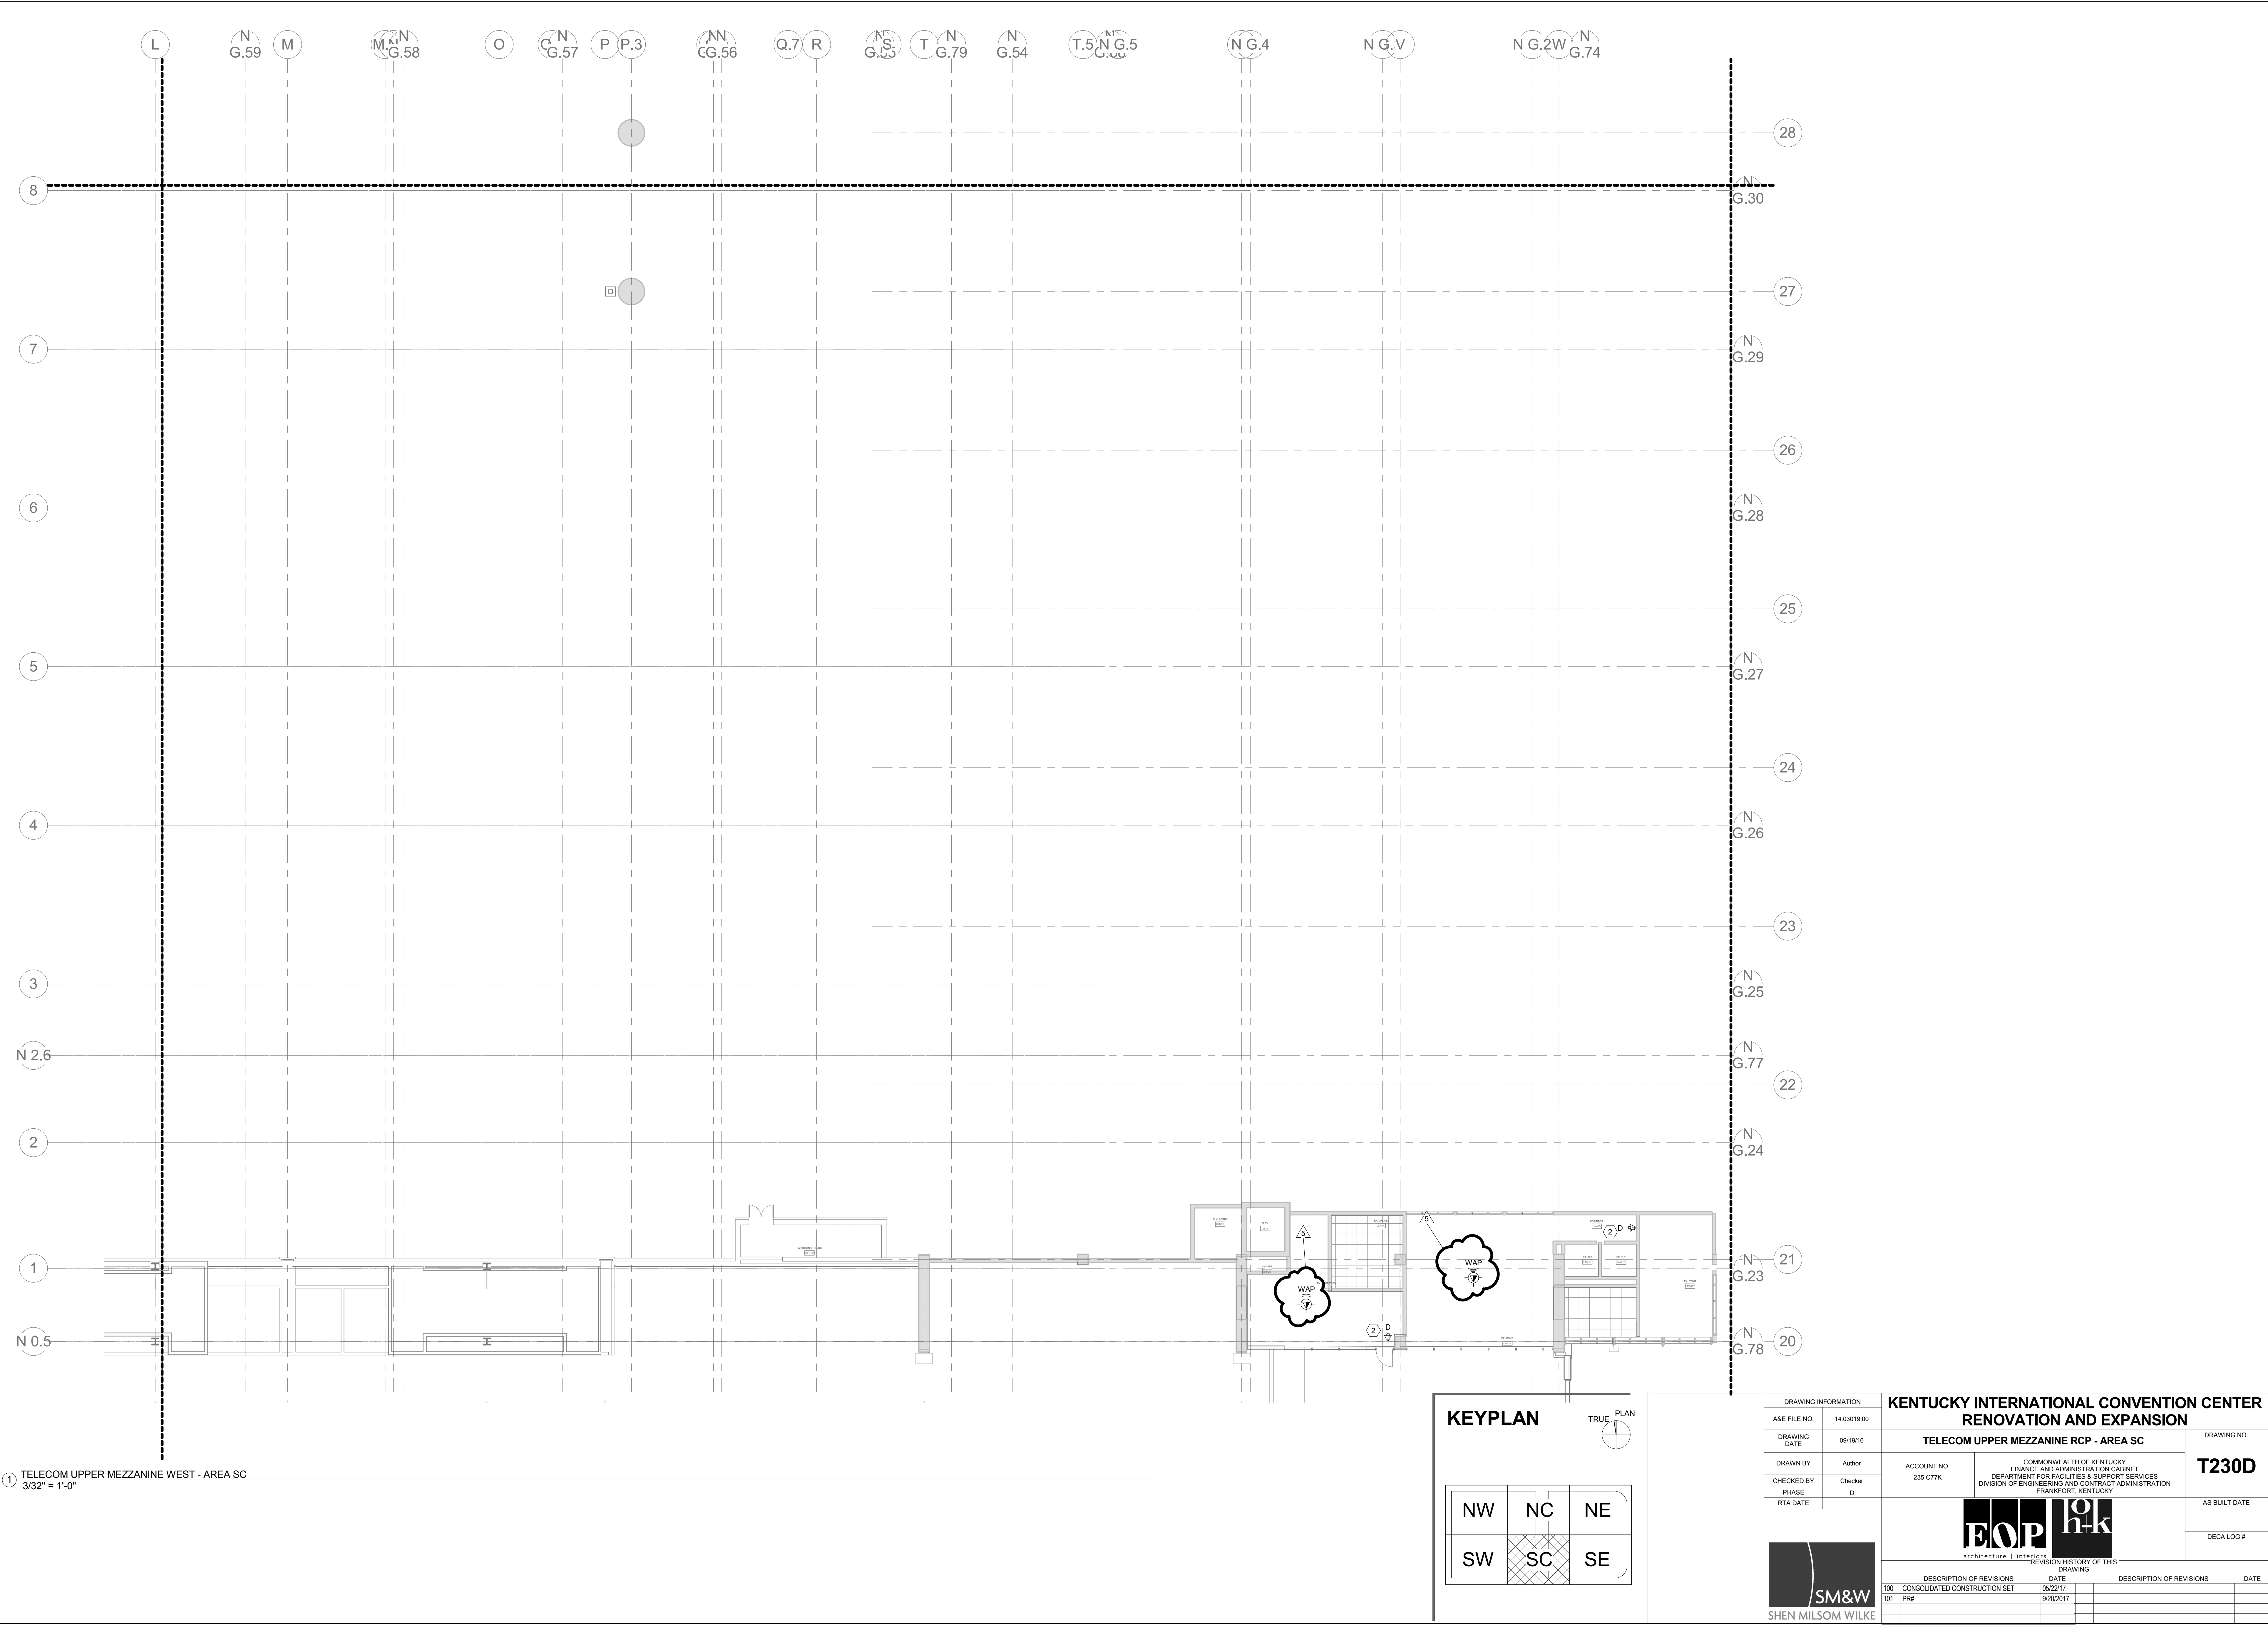


1 TELECOM UPPER MEZZANINE WEST - AREA SC
3/32" = 1'-0"



KEYPLAN

TRUE PLAN

NW	NC	NE
SW	SC	SE

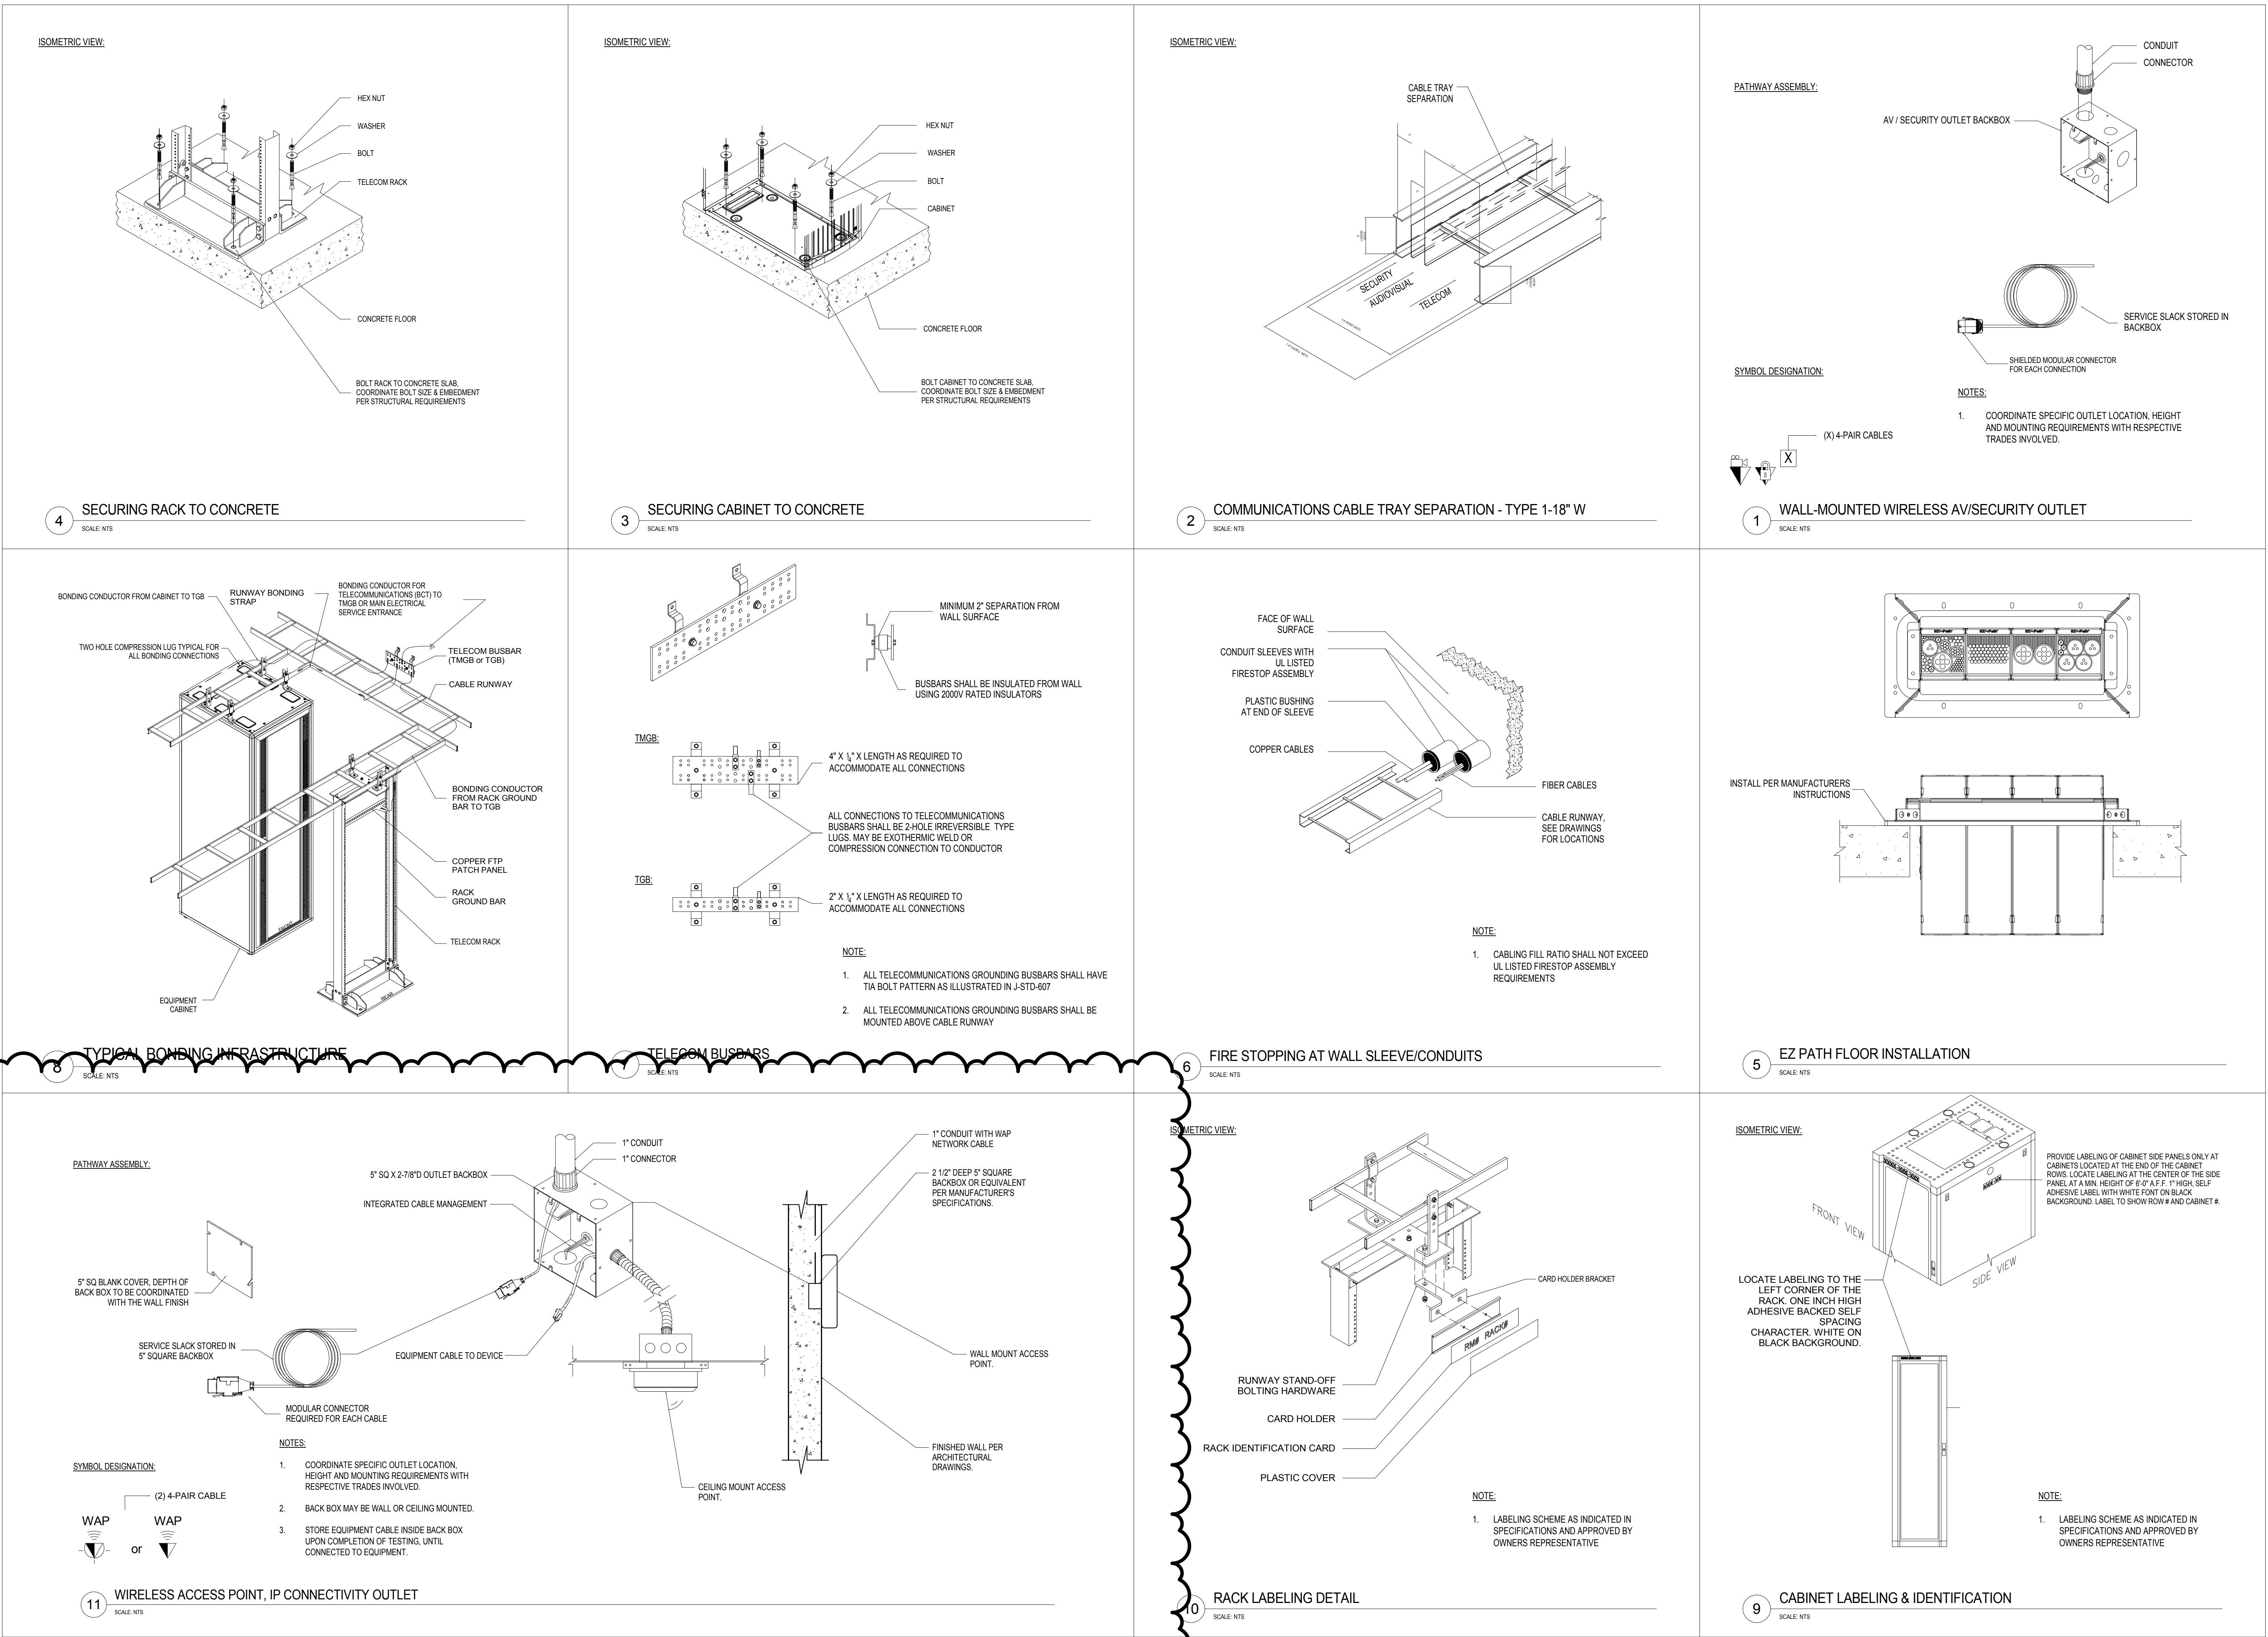DRAWING INFORMATION		KENTUCKY INTERNATIONAL CONVENTION CENTER RENOVATION AND EXPANSION			
A&E FILE NO.	14.03019.00	TELECOM UPPER MEZZANINE RCP - AREA SC		DRAWING NO.	
DRAWING DATE	09/19/16	ACCOUNT NO. 235 C77K		COMMONWEALTH OF KENTUCKY FINANCE AND ADMINISTRATION CABINET DEPARTMENT FOR FACILITIES & SUPPORT SERVICES DIVISION OF ENGINEERING AND CONTRACT ADMINISTRATION FRANKFORT, KENTUCKY	
DRAWN BY	Author	COMMONWEALTH OF KENTUCKY FINANCE AND ADMINISTRATION CABINET DEPARTMENT FOR FACILITIES & SUPPORT SERVICES DIVISION OF ENGINEERING AND CONTRACT ADMINISTRATION FRANKFORT, KENTUCKY		T230D	
CHECKED BY	Checker	COMMONWEALTH OF KENTUCKY FINANCE AND ADMINISTRATION CABINET DEPARTMENT FOR FACILITIES & SUPPORT SERVICES DIVISION OF ENGINEERING AND CONTRACT ADMINISTRATION FRANKFORT, KENTUCKY		AS BUILT DATE	
PHASE	D	COMMONWEALTH OF KENTUCKY FINANCE AND ADMINISTRATION CABINET DEPARTMENT FOR FACILITIES & SUPPORT SERVICES DIVISION OF ENGINEERING AND CONTRACT ADMINISTRATION FRANKFORT, KENTUCKY		DECA LOG #	
RTA DATE		COMMONWEALTH OF KENTUCKY FINANCE AND ADMINISTRATION CABINET DEPARTMENT FOR FACILITIES & SUPPORT SERVICES DIVISION OF ENGINEERING AND CONTRACT ADMINISTRATION FRANKFORT, KENTUCKY		DECA LOG #	
SM&W SHEN MILSOM WILKE		REVISION HISTORY OF THIS DRAWING			
		DESCRIPTION OF REVISIONS	DATE	DESCRIPTION OF REVISIONS	DATE
		100 CONSOLIDATED CONSTRUCTION SET	05/22/17		
		101 PR#	9/20/2017		



DRAWING INFORMATION		KENTUCKY INTERNATIONAL CONVENTION CENTER RENOVATION AND EXPANSION			
A&E FILE NO.	14.03019.00	TELECOM DETAILS		DRAWING NO.	
DRAWING DATE	09/19/16	ACCOUNT NO. 236 C77K		T501	
DRAWN BY	RZ	COMMONWEALTH OF KENTUCKY FINANCE AND ADMINISTRATION CABINET DEPARTMENT FOR FACILITIES & SUPPORT SERVICES DIVISION OF ENGINEERING AND CONTRACT ADMINISTRATION FRANKFORT, KENTUCKY		AS BUILT DATE	
CHECKED BY	JF	 architecture interior		DECA LOG #	
RTA DATE	D			REVISION HISTORY OF THIS DRAWING	
 SHEN MILSOM WILKE		DESCRIPTION OF REVISIONS	DATE	DESCRIPTION OF REVISIONS	DATE
		100 CONSOLIDATED CONSTRUCTION SET	05/22/17		
		101 PR#	9/20/2017		